


C 36046

T.17S.R.20 E.W.M.

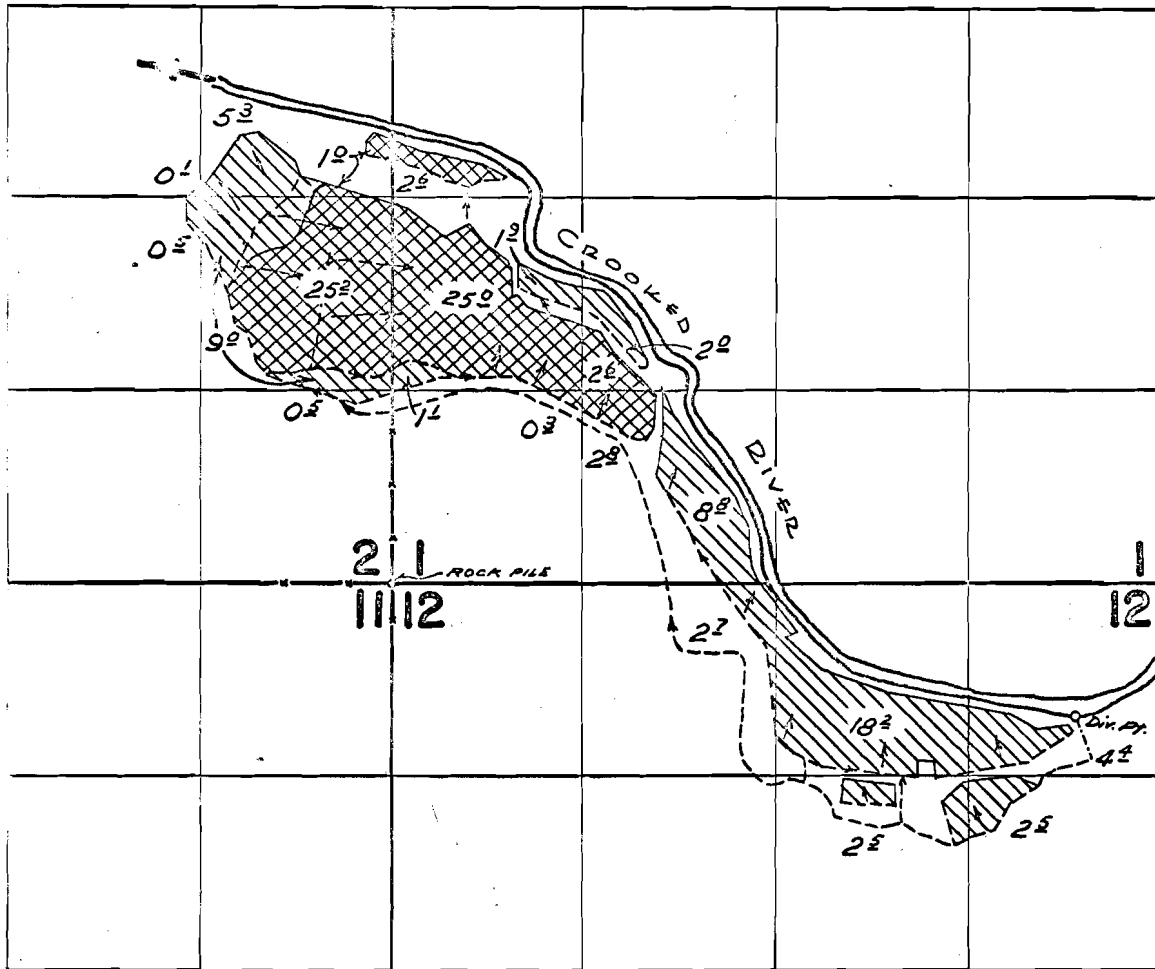

 PRIMARY
  SUPPLEMENTAL

Div. Pt. Located 920 ft. S. & 4680 ft. E. from N.W. Cor. Sec. 12

FINAL PROOF SURVEY UNDER

Application No. 33192..... Permit No. 26250.....
IN NAME OF

FRANIZ S. McCULLOUGH

Surveyed July..10.. 1963, by T. LAUGE.....

P# 26250