


T.33&34S.R.11 W.W.M.

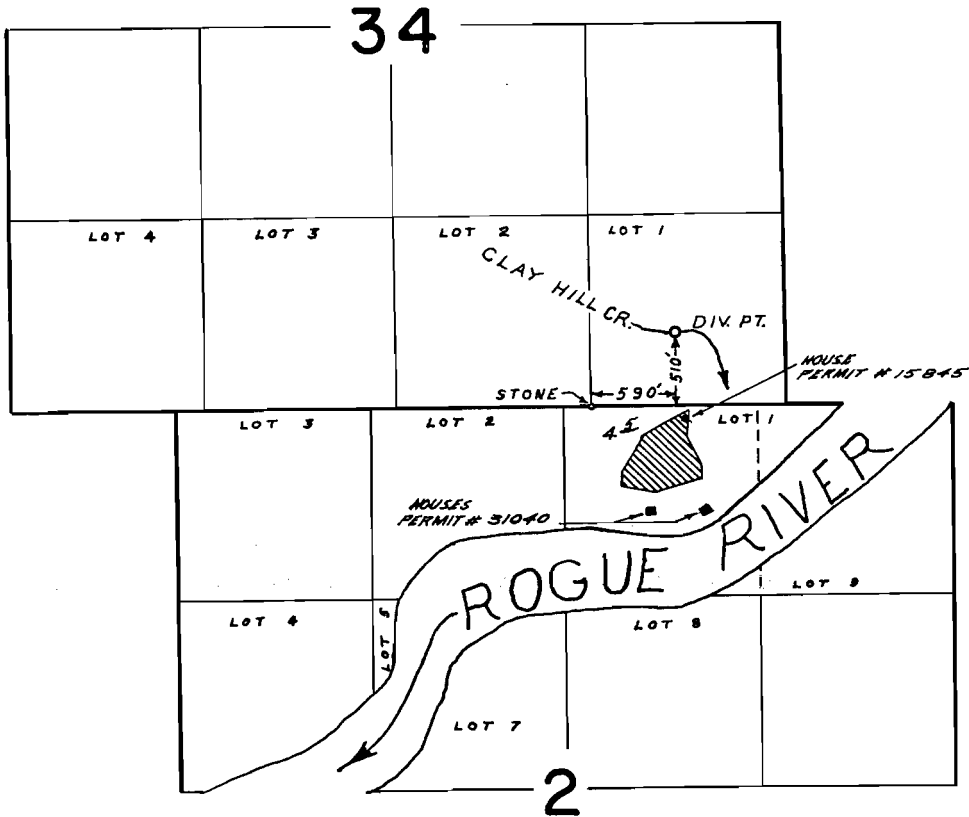

**FINAL PROOF SURVEY**  
UNDER

Application No. 20311 41907 Permit No. 15845 31040  
IN NAME OF

THOMAS G. STALEY

Surveyed SEPT. 10, 1968, by L. E. GOULD