


T.33&34S.R.11 W.W.M.

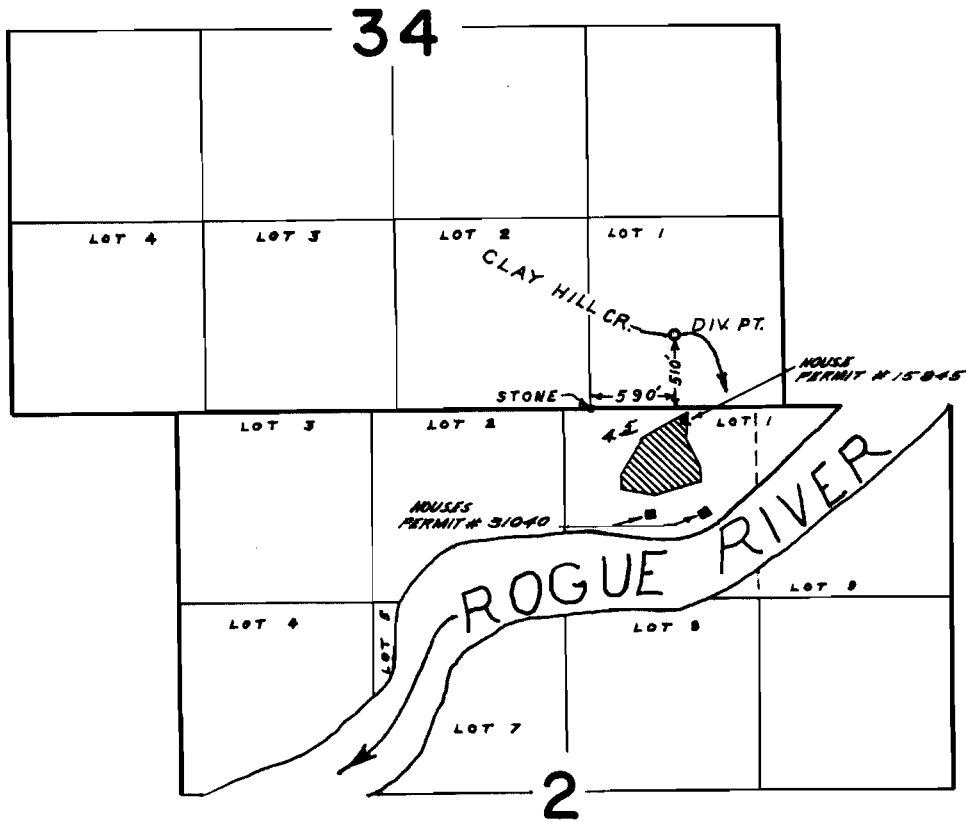

**FINAL PROOF SURVEY**  
UNDER

Application No. **20311** / **41907** Permit No. **15845** / **31040**  
IN NAME OF

**THOMAS G. STALEY**

Surveyed **SEPT. 10, 1968**, by **L. E. GOULD**