


T.34S.R.11W.W.M.

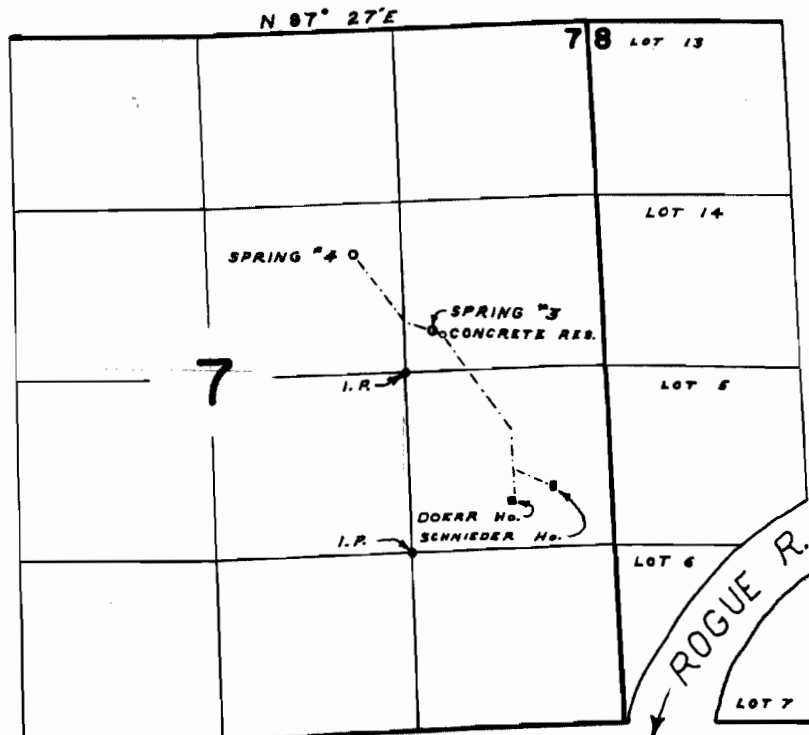

SPRINGS LOCATED: "3; 280' N & 180' E: "4; 820' N & 350' W: BOTH FROM THE SW COR. SE $\frac{1}{4}$, NE $\frac{1}{4}$ SEC. 7

FINAL PROOF SURVEY
UNDER

Application No. **34564** Permit No. **27146**
IN NAME OF

ROBERT P and MONICA DOERR

Surveyed **SEPT. 12 1968**, by **L. E. GOULD**