


T. 35S. R. 11W. W.M.

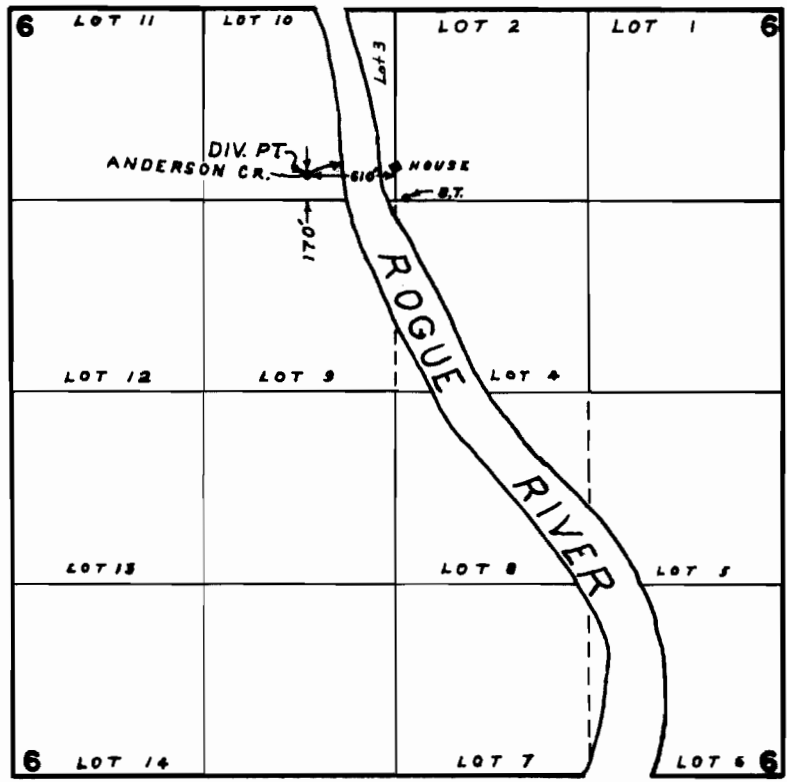

**FINAL PROOF SURVEY**  
UNDER

Application No. 34886 Permit No. 27399  
IN NAME OF

RUSSELL F. HILL and SARAH VIOLA HILL

Surveyed SEPT. 14 1968, by L. E. GOULD