


T.35S.R.11 W. W.M.

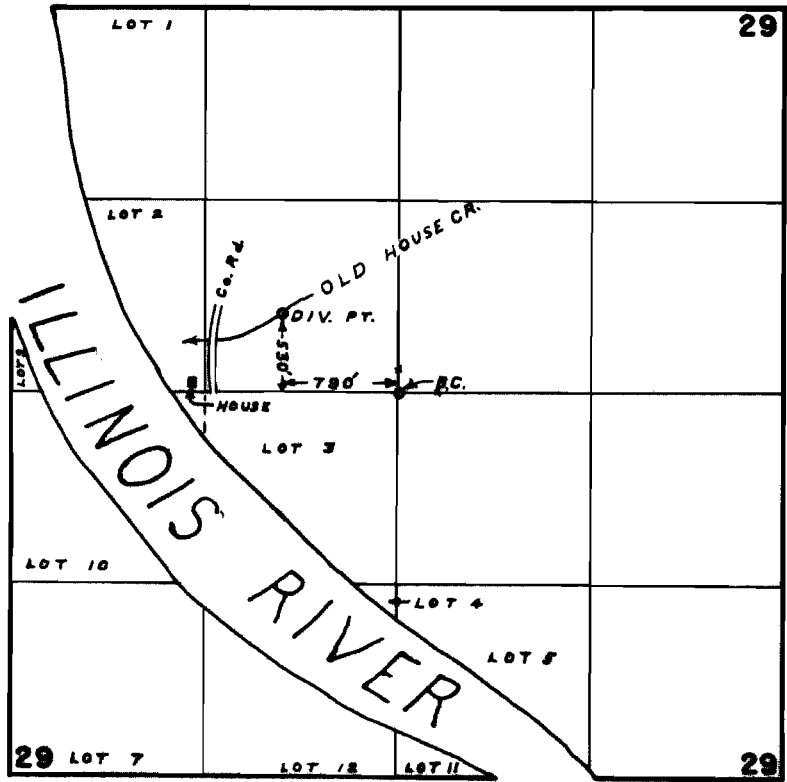

**FINAL PROOF SURVEY**  
UNDER

Application No. 41249 Permit No. 30760  
IN NAME OF

DEWEY H. and VIEATTA M. GILKEY

Surveyed SEPT. 13 1968, by L. E. GOULD