


T. 11 S. R. 29 E. W. M.

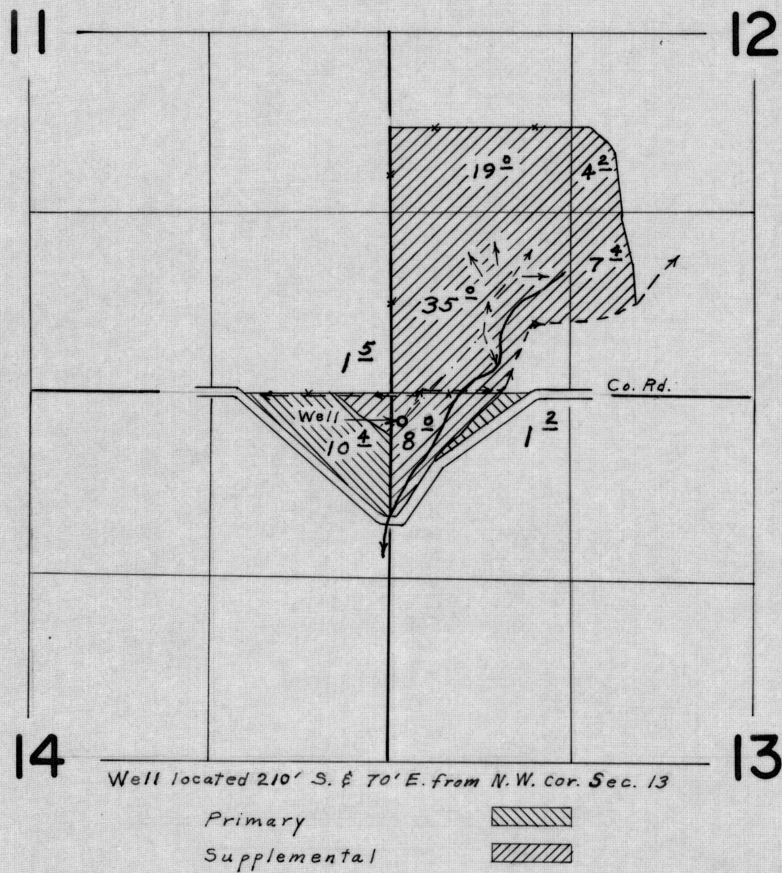

FINAL PROOF SURVEY
UNDER

Application No. G 3643 Permit No. G 3423
IN NAME OF

JACK E. JOHNS

Surveyed June 7, 1968, by L. E. Gould