


T. 9 S. R. 27 E. W.M. .

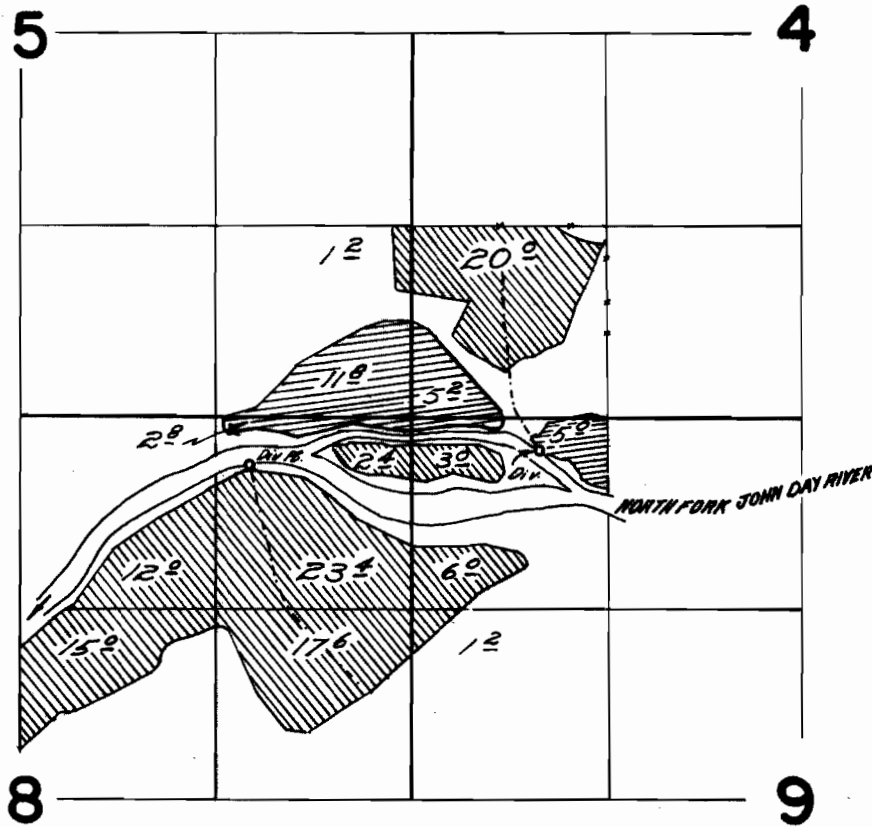

DIVERSION POINTS LOCATED 1650 FT. S. & 2450 FT. W.; &
1450 FT. S. & 470 FT. W.; BOTH FROM N.E. CORNER
SW 1/4 SW 1/4 SECTION 4.

 TRANSFER C-128

PERMIT 26207 

FINAL PROOF SURVEY
UNDER


TRANSFER C-128

Application No. 33138.. Permit No. 26207
IN NAME OF

W. & E. MILLER RANCHES, INC.

Surveyed July 10, 1964, by George M. Wood
May 15, 1968 by W. d. Ruppert

T.9S.R.27E.W.M.

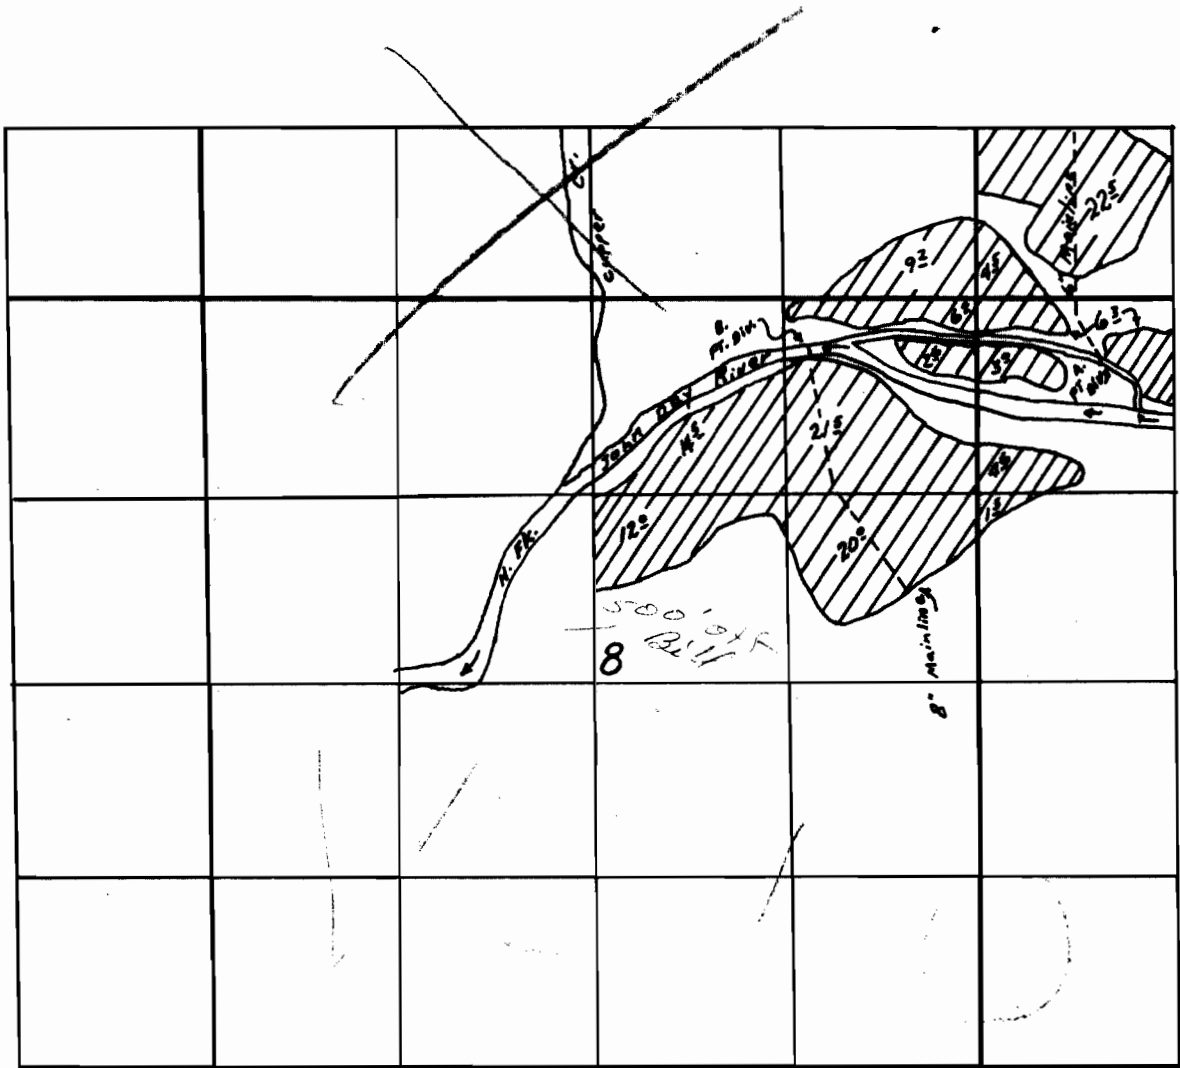

FINAL PROOF SURVEY
UNDER

Application No. 33132 Permit No. 26207
IN NAME OF

Harold H. Cork

Surveyed July 10, 1964, by G. Ward