


T.24&25S.R.36E.W.M.

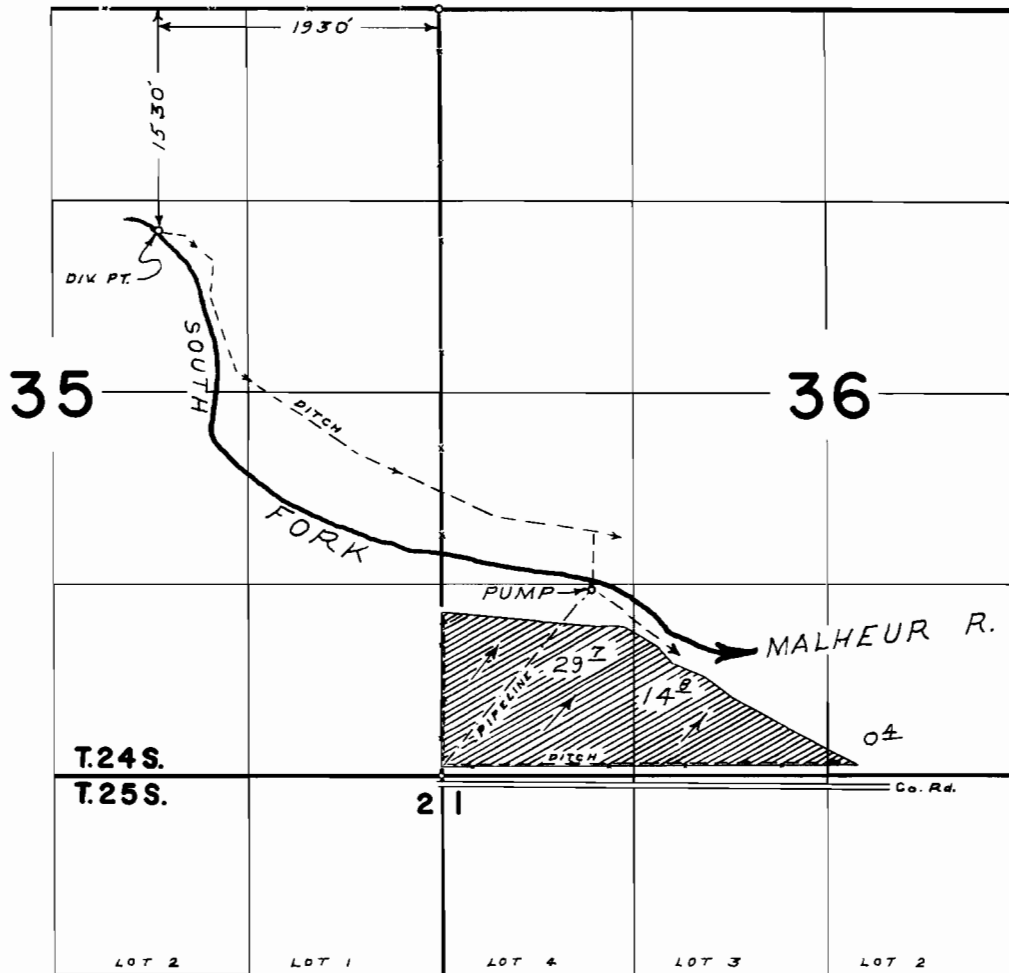

FINAL PROOF SURVEY UNDER

Application No. **34884** Permit No. **27918**
IN NAME OF

LEE CABLES

Surveyed **SEPT. 13, 1968**, by **W. J. RUPPERT**