


T. 34 S. R. 1 W. W. M.

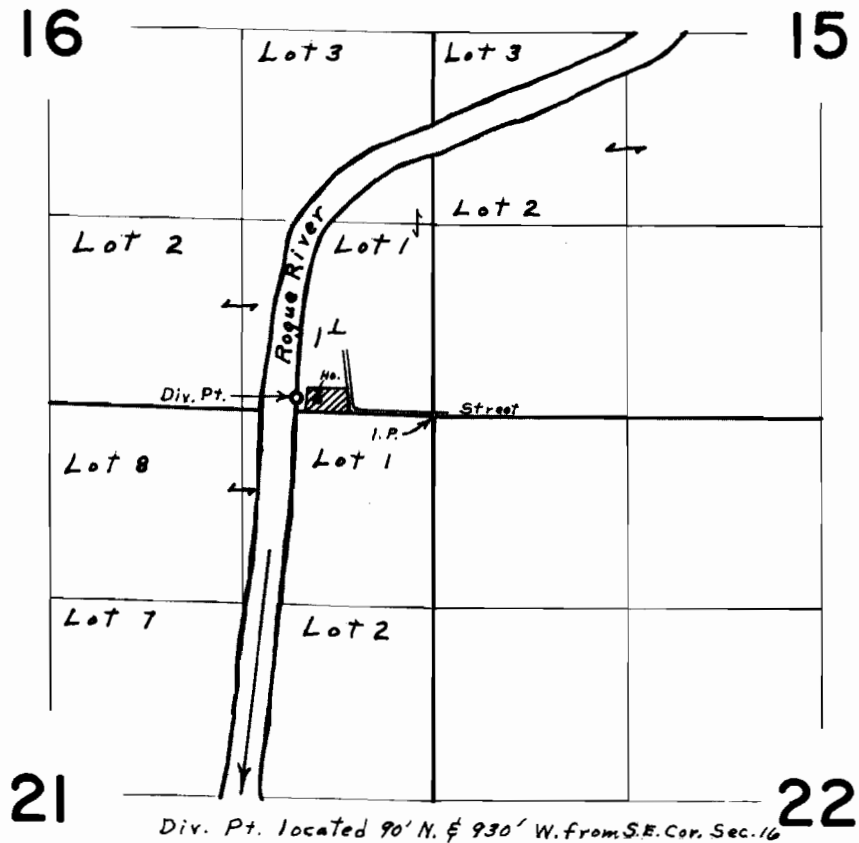

FINAL PROOF SURVEY
UNDER

Application No. 34559 Permit No. 27143
IN NAME OF

STEWART M. PENINGTON

Surveyed May 18, 1968, by L. E. Gould