


T.33 S.R.2 E.W.M.

T.32 S.R.3 E.W.M.

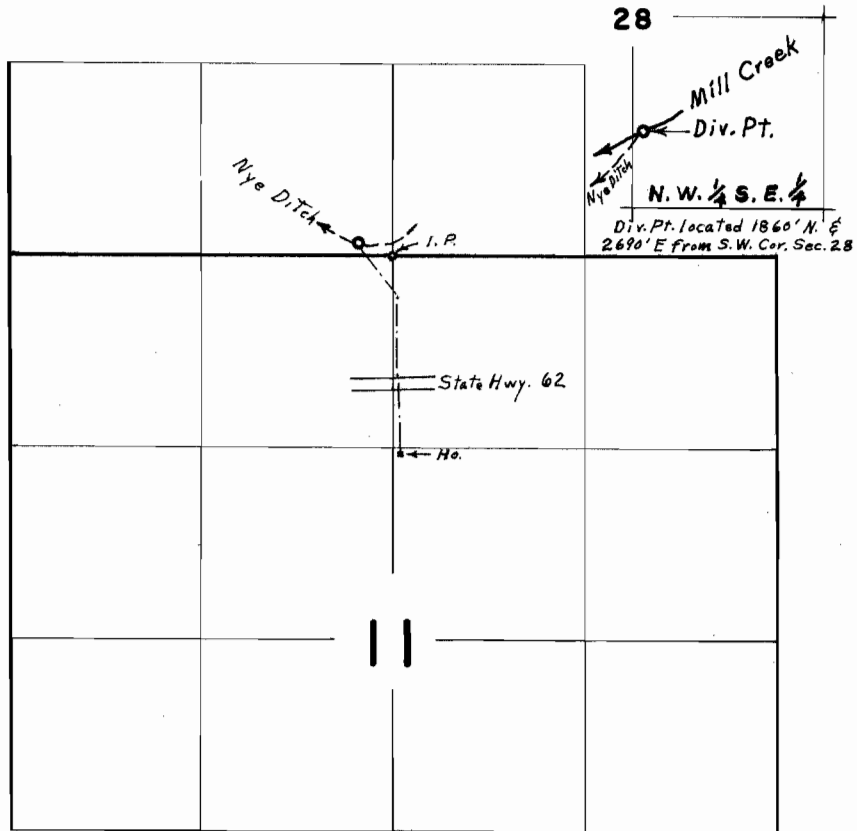

FINAL PROOF SURVEY UNDER

Application No. 38475 Permit No. 28650
IN NAME OF

A. A. & MARY VALENTINE

Surveyed May 15, 1968, by L. E. Gould