


T. 33 S. R. 2 E. W. M.

T. 32 S. R. 3 E. W. M.

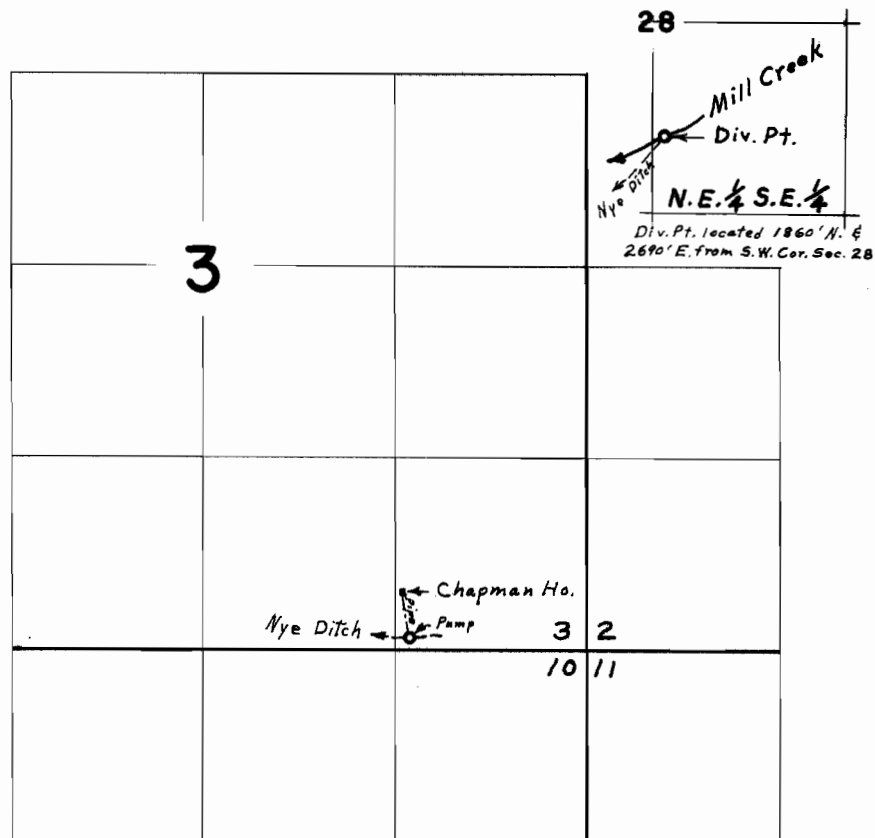

FINAL PROOF SURVEY
UNDER

Application No. 39403 Permit No. 29367
IN NAME OF

SHAROLD W. CHAPMAN

Surveyed May 20, 1967, by W. J. Ruppert
May 13, 1968 L. E. Gould