


G-1538
36067

T. 36 S. R. 11 E. W. M.

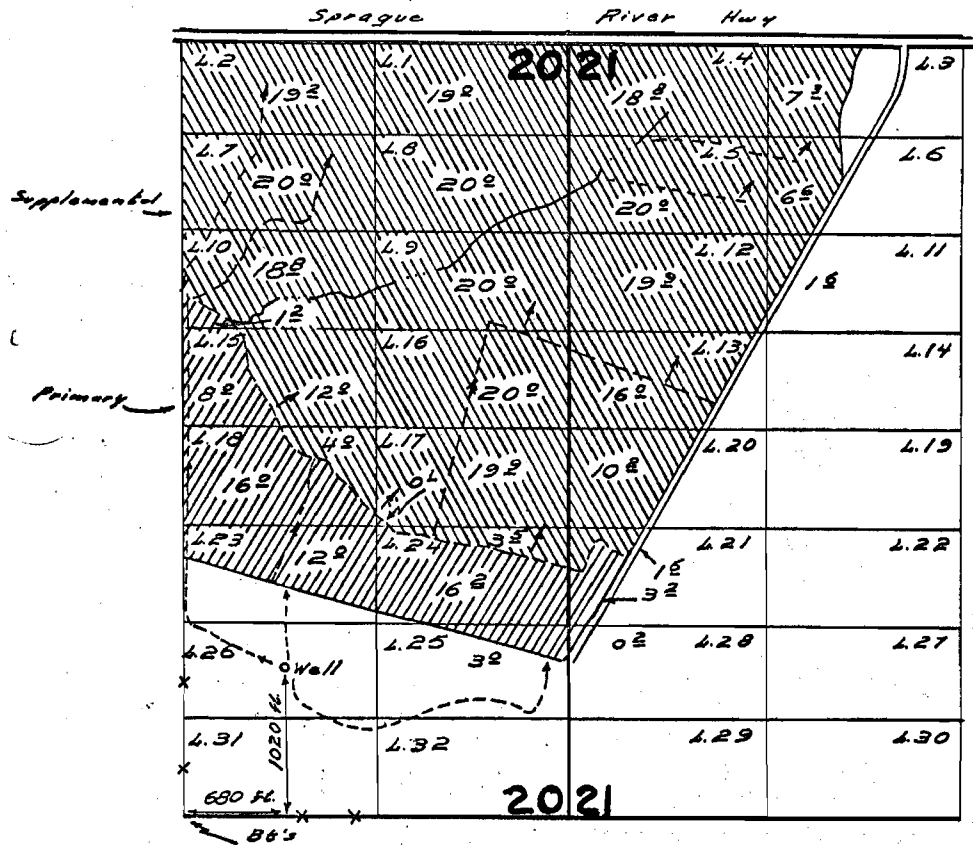

Sprague Riv. wells

FINAL PROOF SURVEY UNDER

Application No. G-1673 Permit No. G-1538
IN NAME OF

BENJAMIN E. & BESSIE BERTRAN

Surveyed Oct. 12, 1966 by W. J. Ruppert