



29505
3668

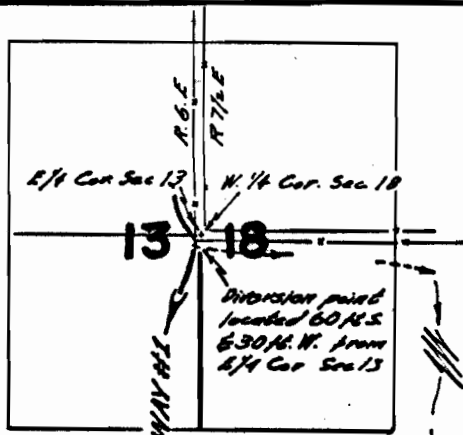

T. 33 S. R. 7 1/2 E. W. M.

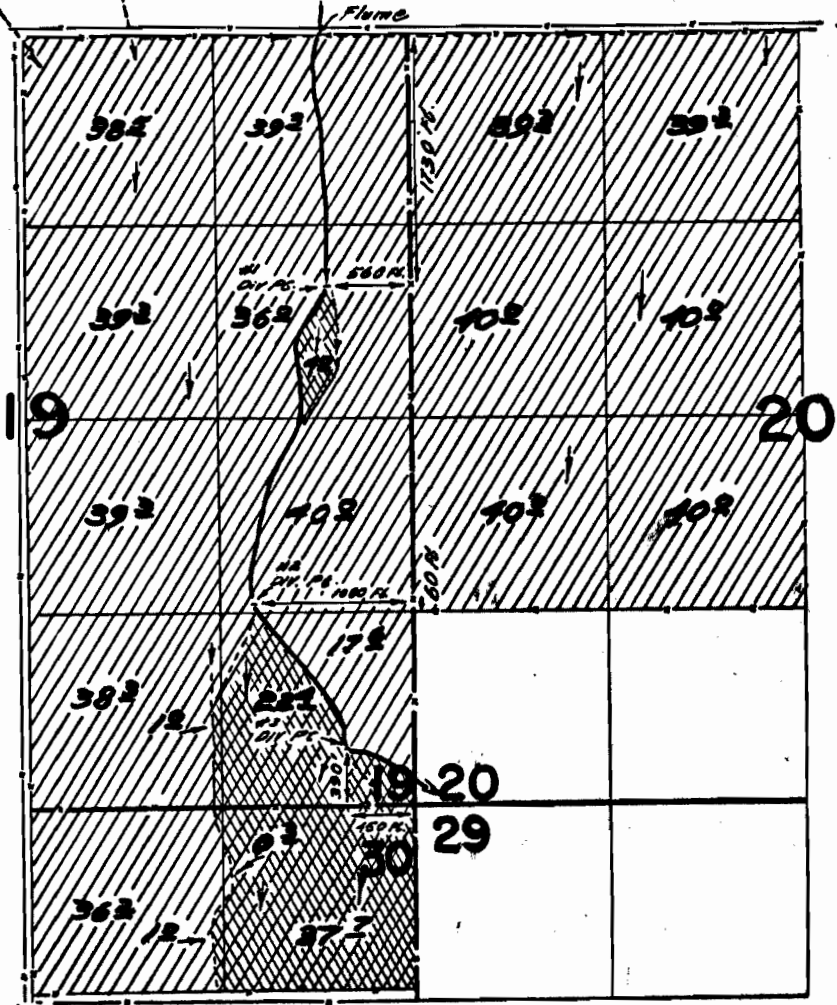

FINAL PROOF SURVEY
UNDER



Application No. 39247... Permit No. 29505...
IN NAME OF

LLOYD NICHOLSON

Surveyed August 22 1968, by W.A. Ruppert...