


29518
36670

T. 33 & 34 S. R. 7½ E. W.M.

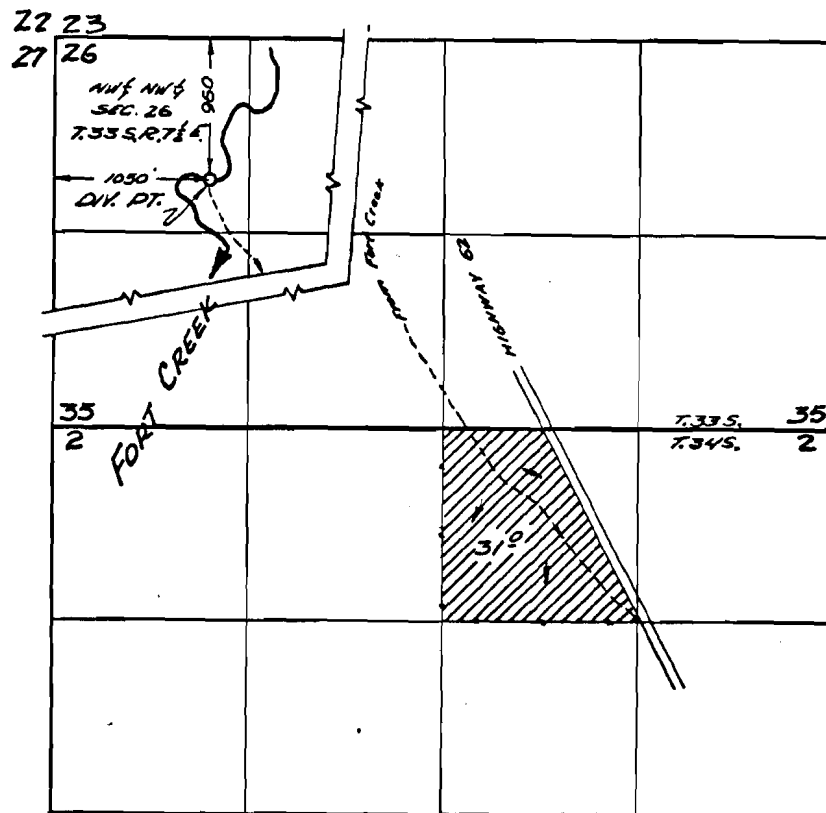

FINAL PROOF SURVEY
UNDER

Application No. 39608 Permit No. 29518
IN NAME OF

WILLIAM S. & DONNA L. NICHOLSON

Surveyed June 6, 1967, by V. Garner