


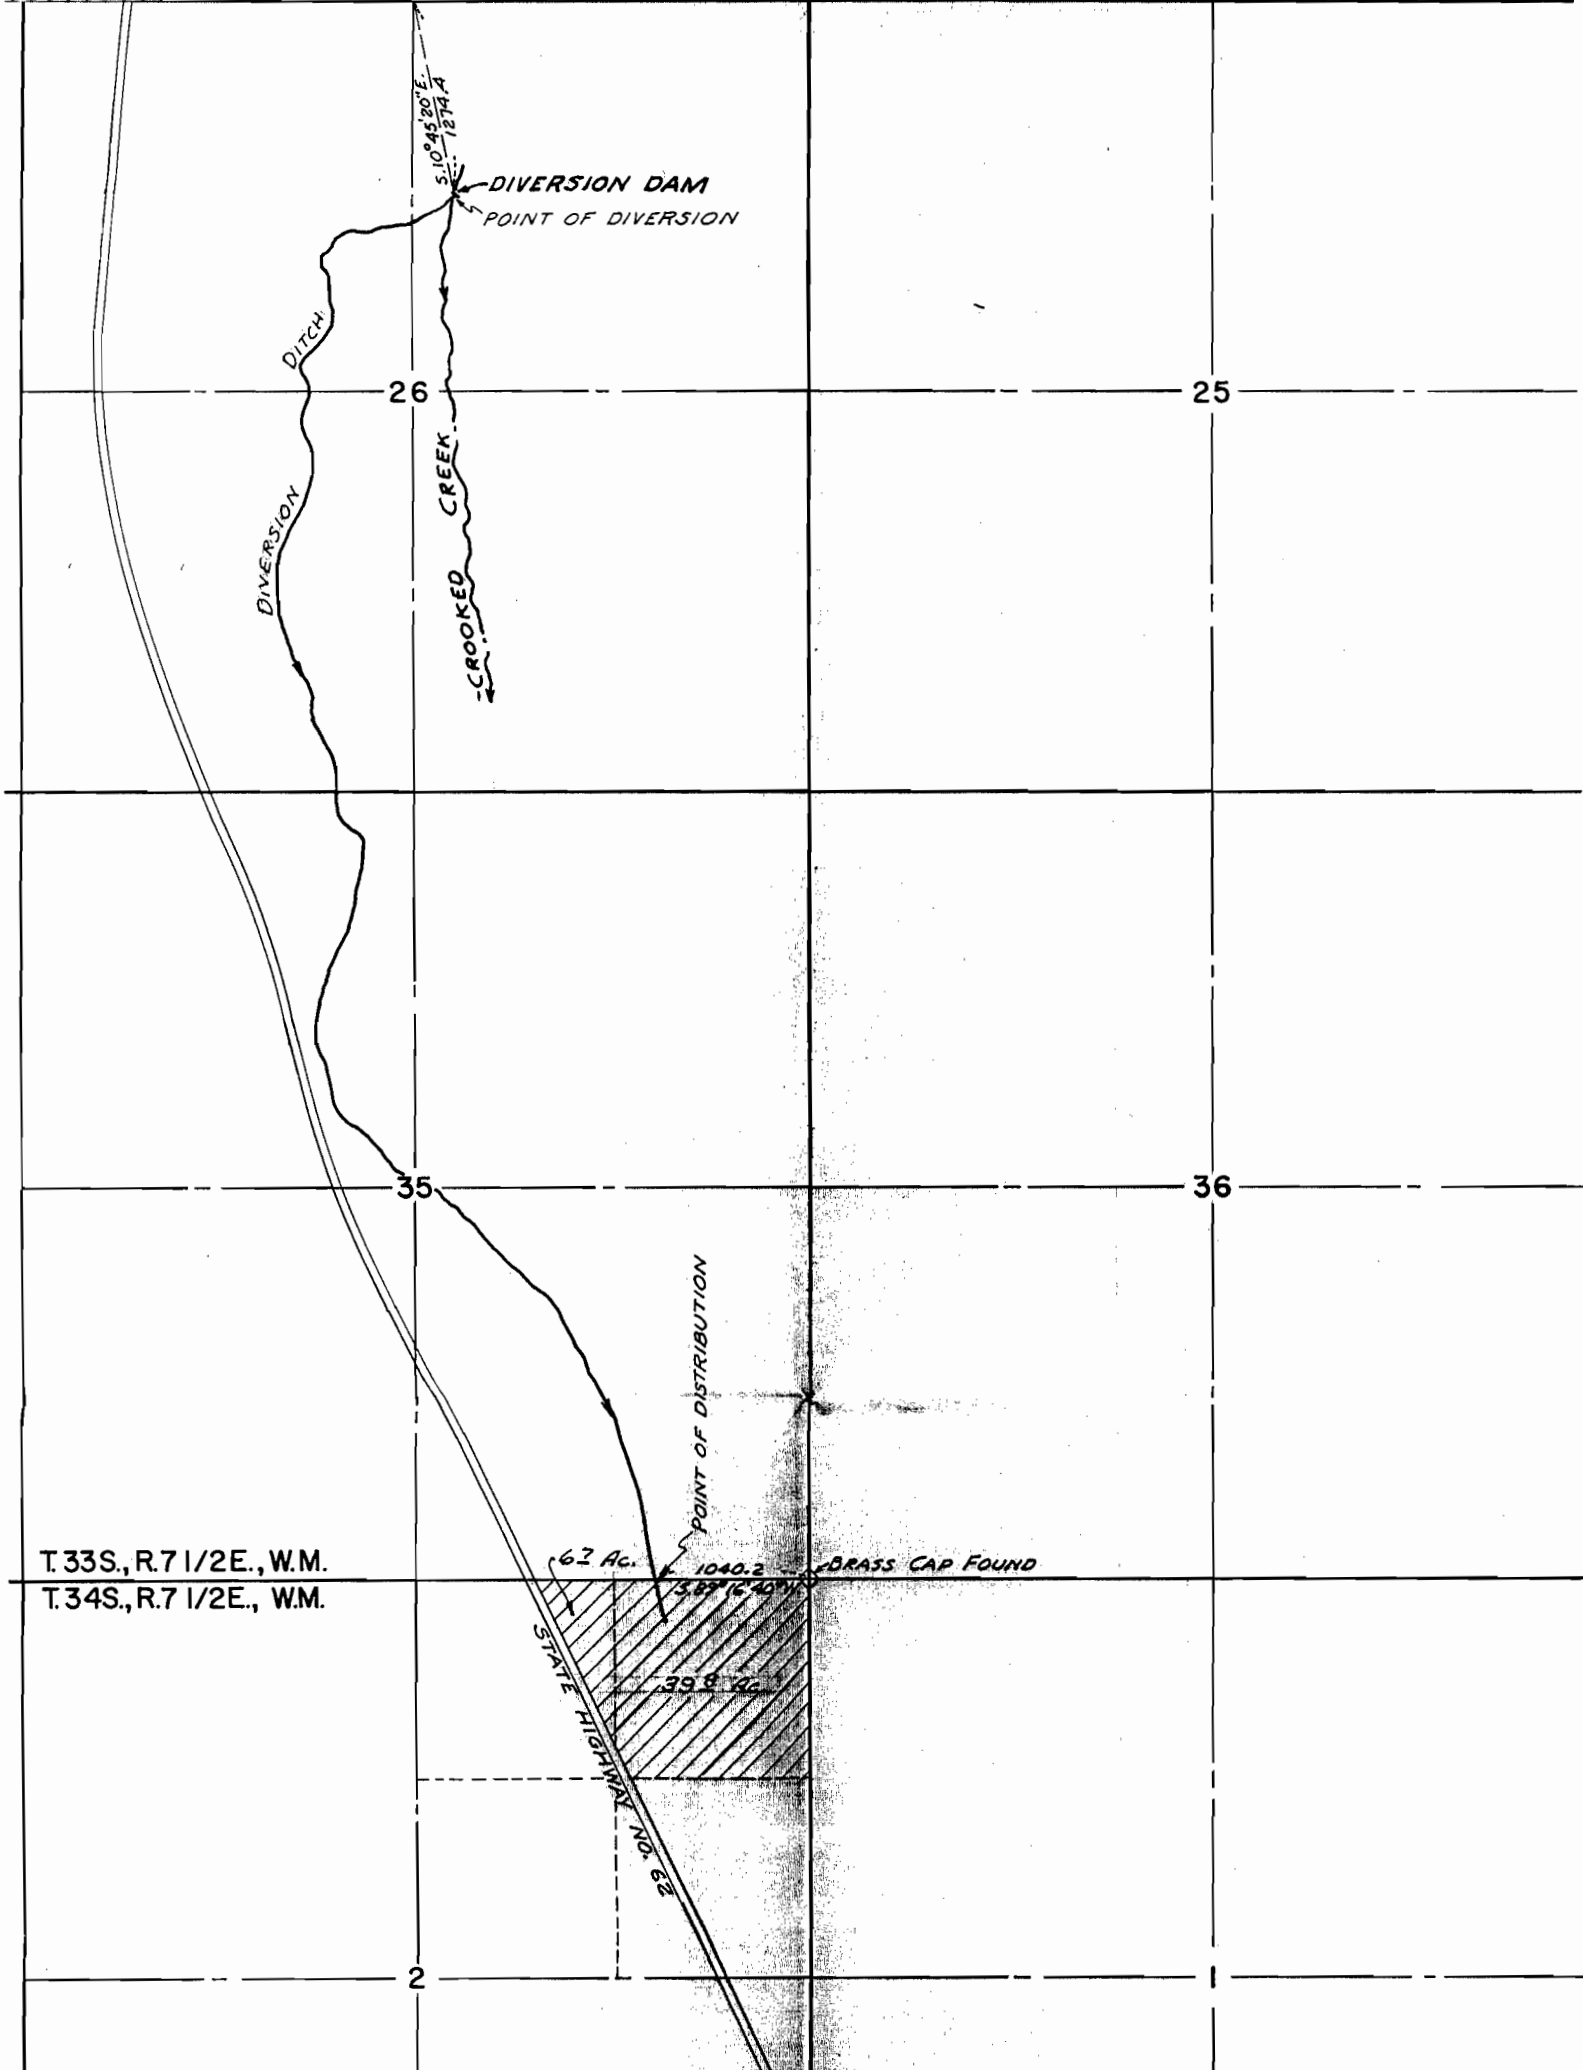

DIVERSION DAM
POINT OF DIVERSION

DITCH

CROOKED CREEK

DIVERSION

POINT OF DISTRIBUTION

62 AC.

1040.2

BRASS CAP FOUND

39.8 AC.

STATE HIGHWAY

T.33S., R.7 1/2 E., W.M.
T.34S., R.7 1/2 E., W.M.


2

25


26

36

35

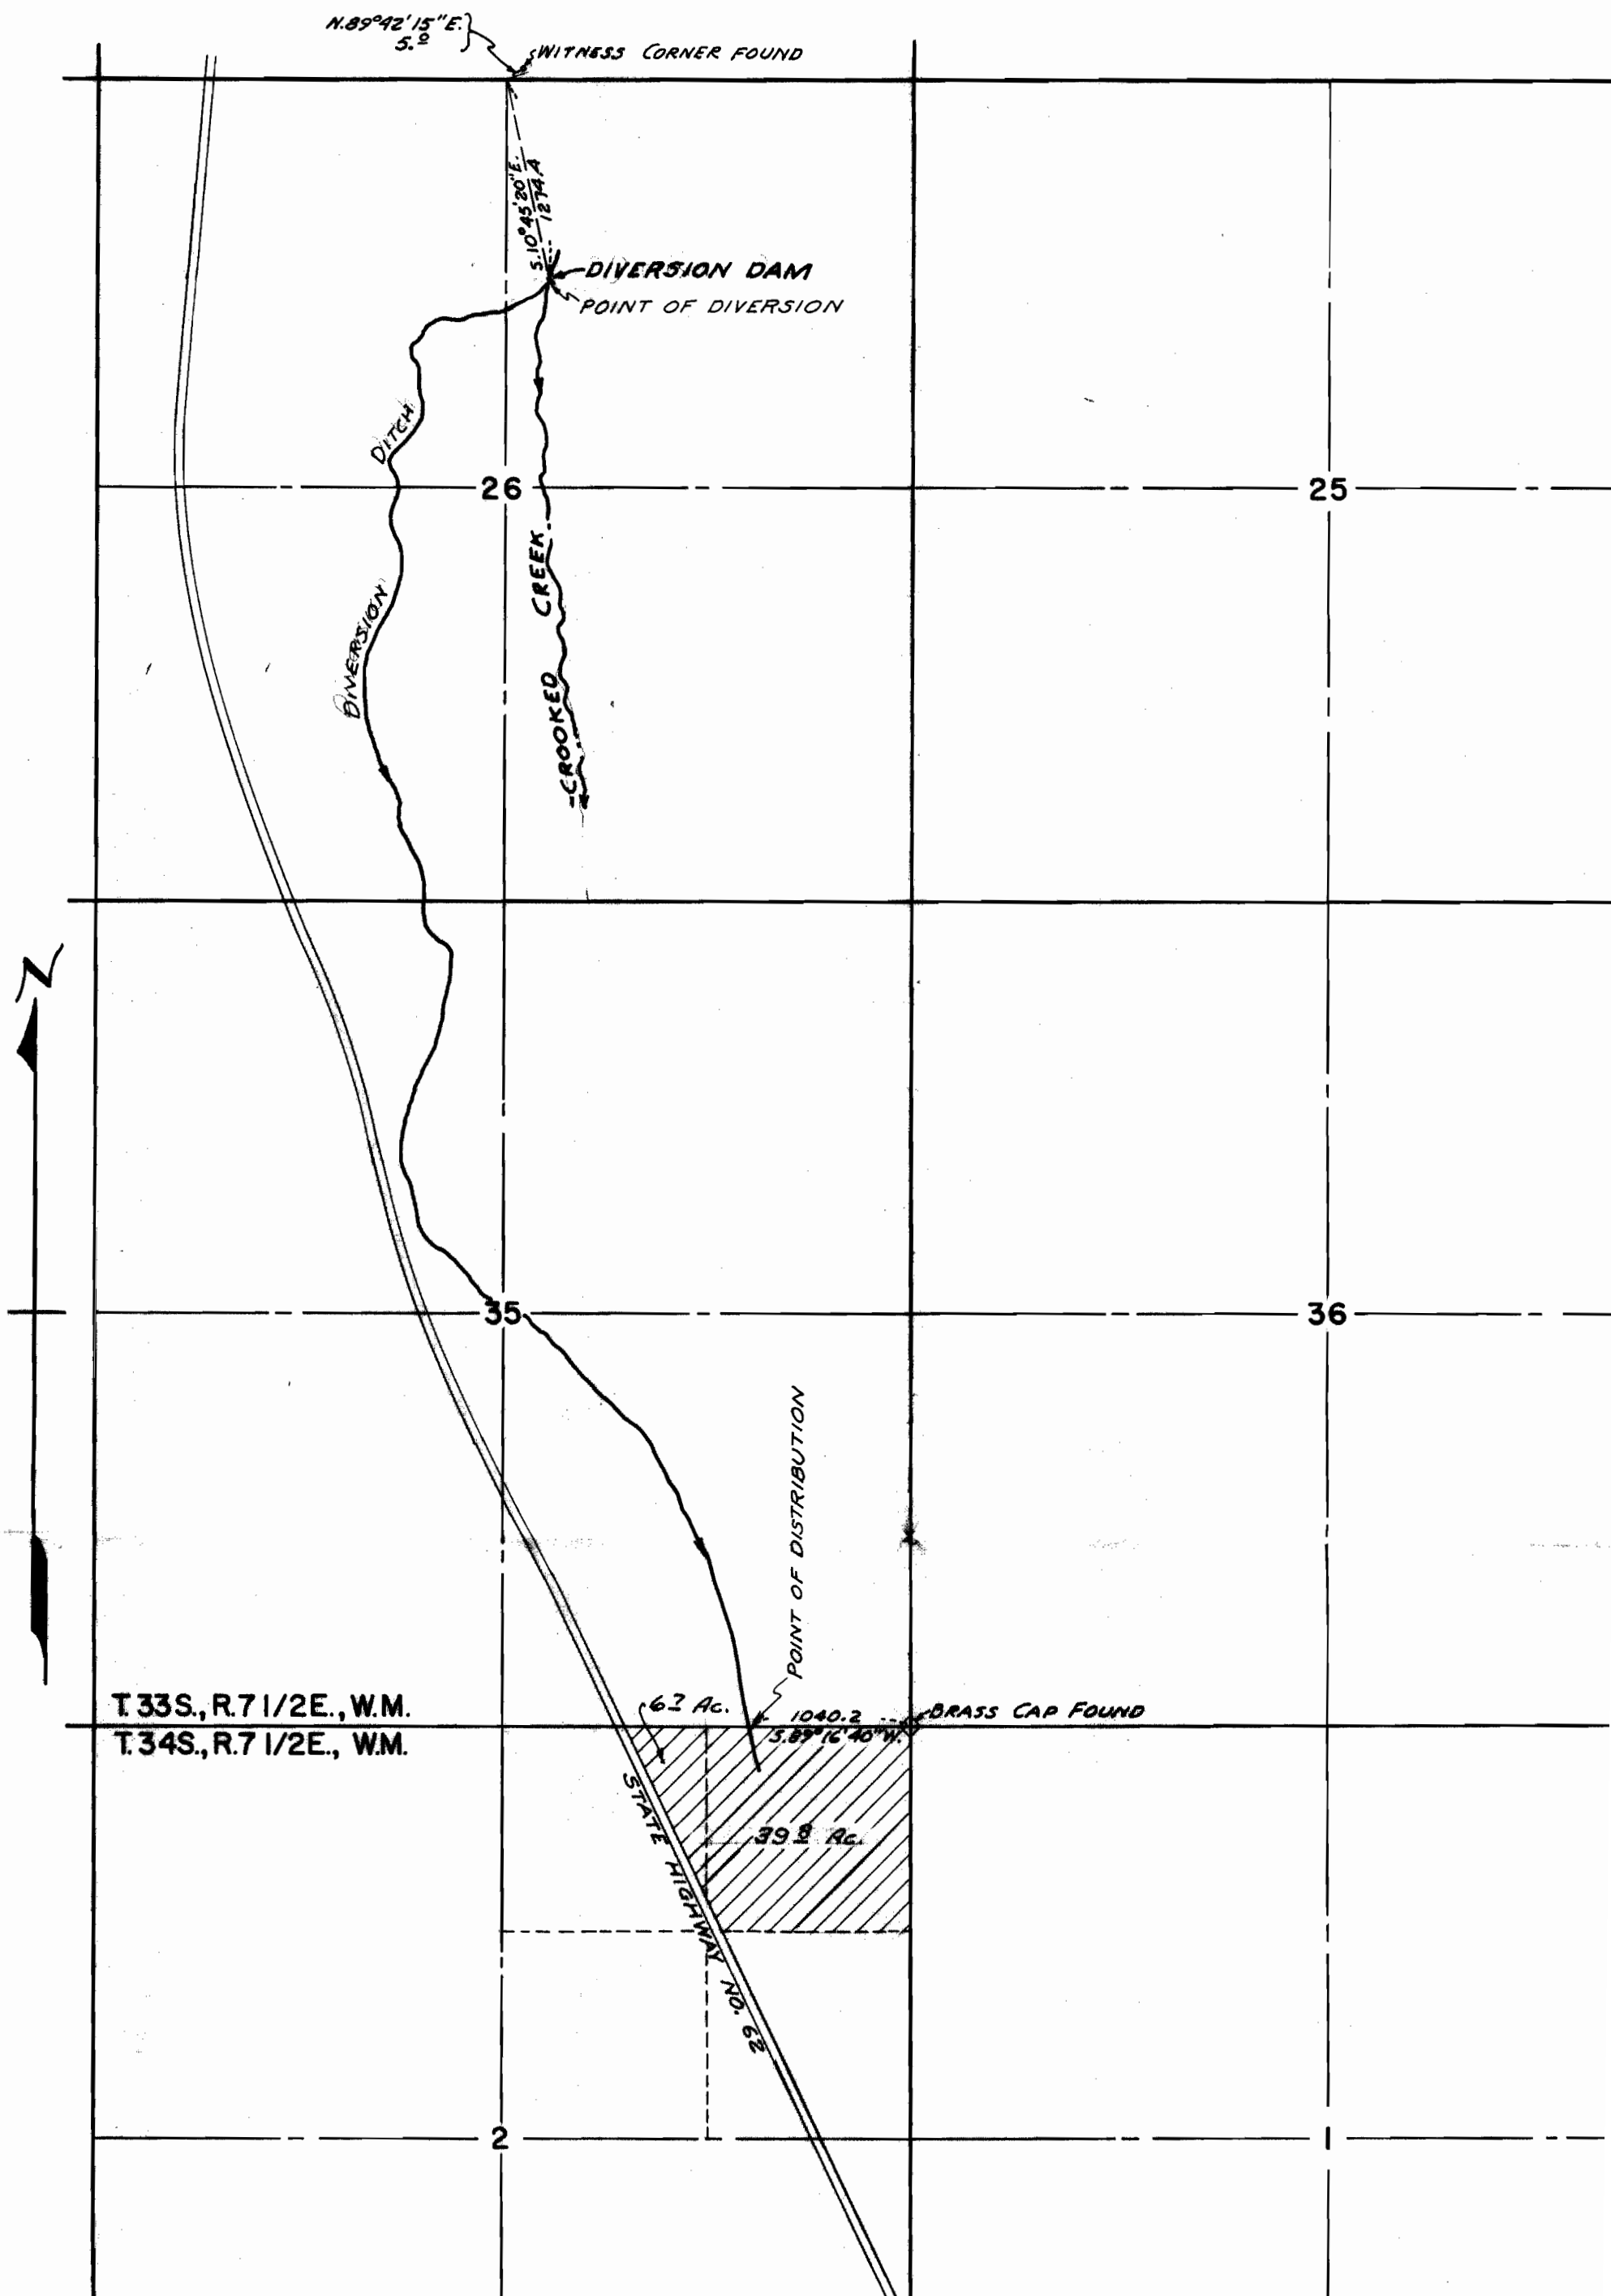


T.33S., R.7 1/2E., W.M.
T.34S., R.7 1/2E., W.M.

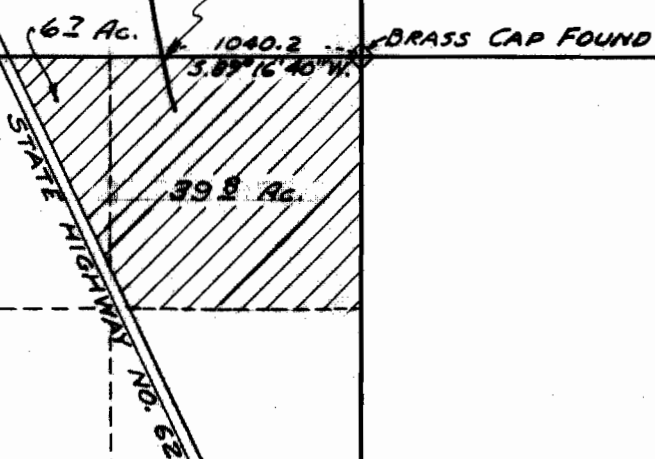

POINT OF DIVERSION and POINT OF DISTRIBUTION
located by actual field surveys.

Application No. 39609
Permit No. 29519

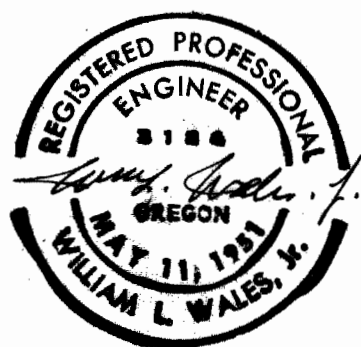

MAP SHOWING
LANDS TO BE IRRIGATED
BY
WILLIAM & VIRGINIA E.
IN
SEC. 2, T.34S., R.7 1/2E.,
KLAMATH COUNTY
Scale 1 in. = 1000 ft.
Survey & Map by:
JANUARY 1964
WILLIAM L. VALES,
CONSULTING ENGINEER
Klamath Falls, ORE.