


T.17S.R.1W.W.M.

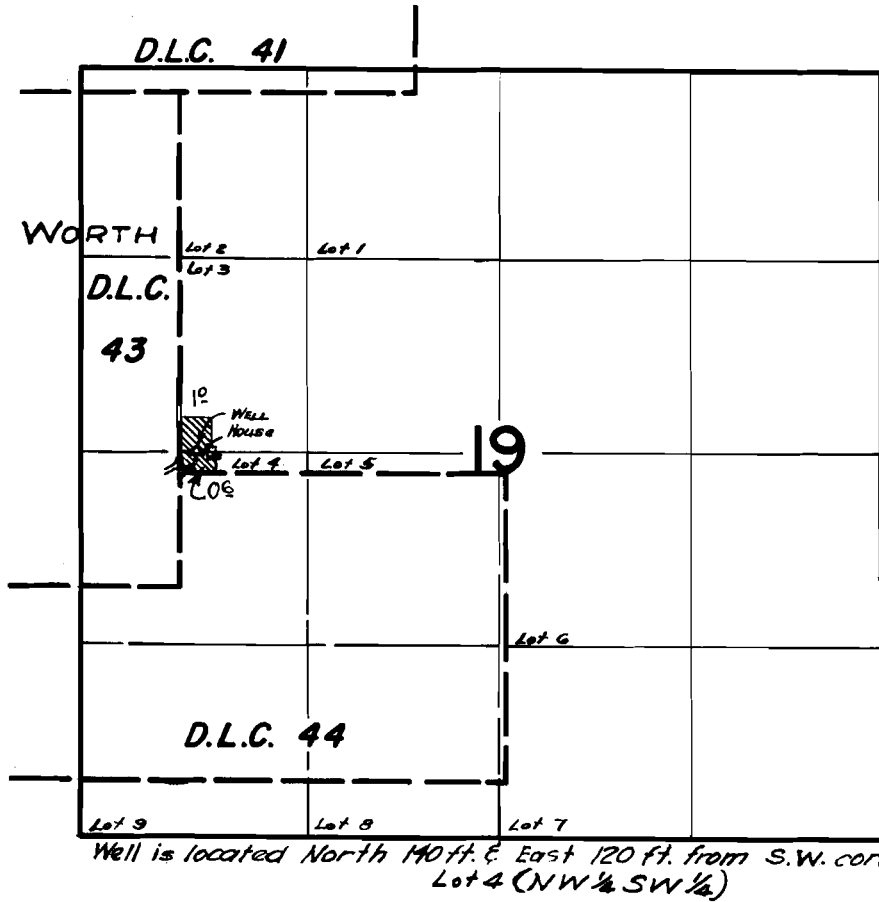

FINAL PROOF SURVEY UNDER

Application No. **G-3070** Permit No. **G-2861**
IN NAME OF

ALVIN K. BERRY

Surveyed Sept. 30, 1968, by

A. Jackson