


T.17S.R.3W.W.M.

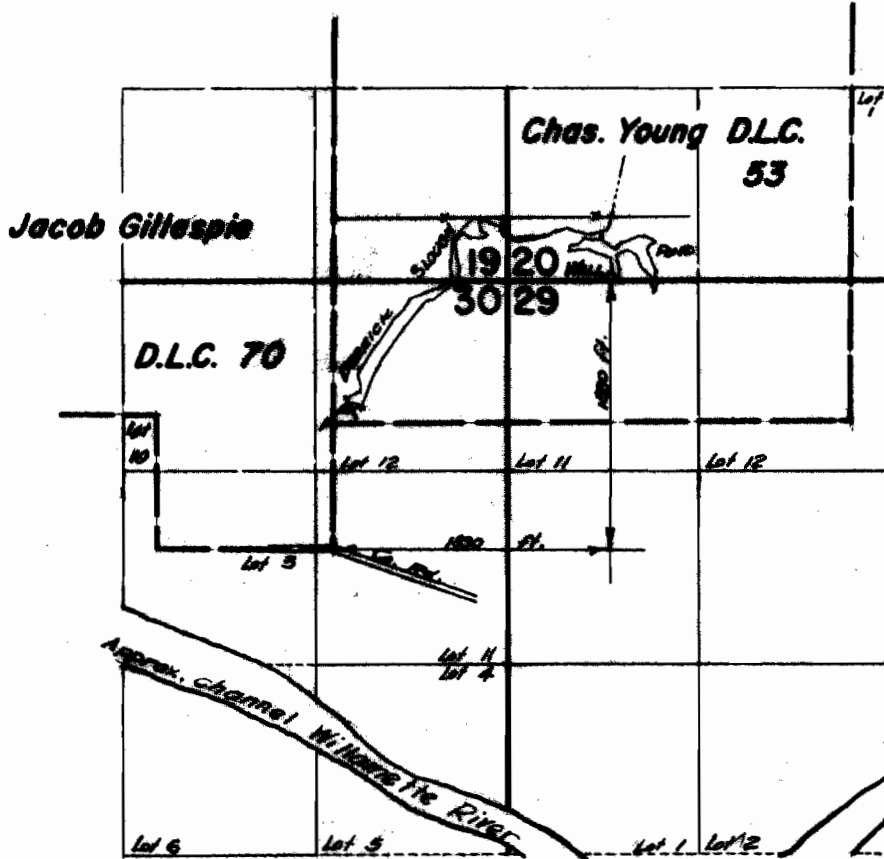

FINAL PROOF SURVEY
UNDER

G-3873 G-3894
Application No. R-41521.. Permit No. R-5131....
IN NAME OF

EUGENE COUNTRY CLUB

Surveyed Sept. 22 1968, by *A. Jackson*