


T.17S.R.3W.W.M.

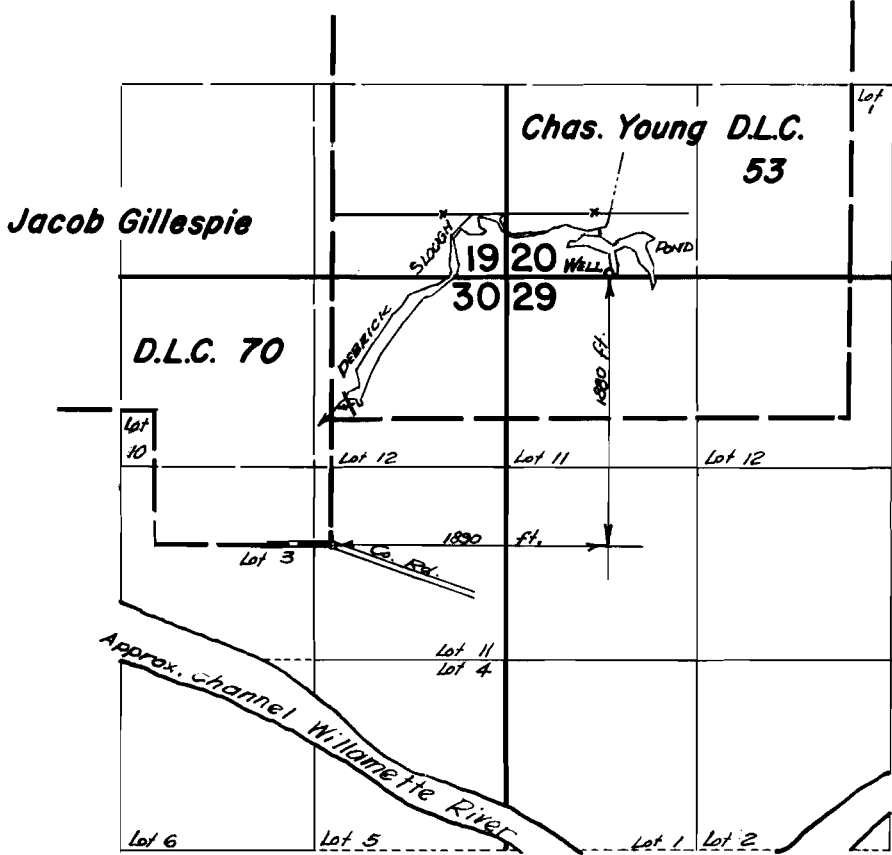

**FINAL PROOF SURVEY**  
UNDER

G-3273                      G-3894  
Application No. R-41521.. Permit No. R-5131....  
IN NAME OF

**EUGENE COUNTRY CLUB**

Surveyed *Sept. 20 1968* by *A. Jackson*