


T.19S.R.1W.W.M.

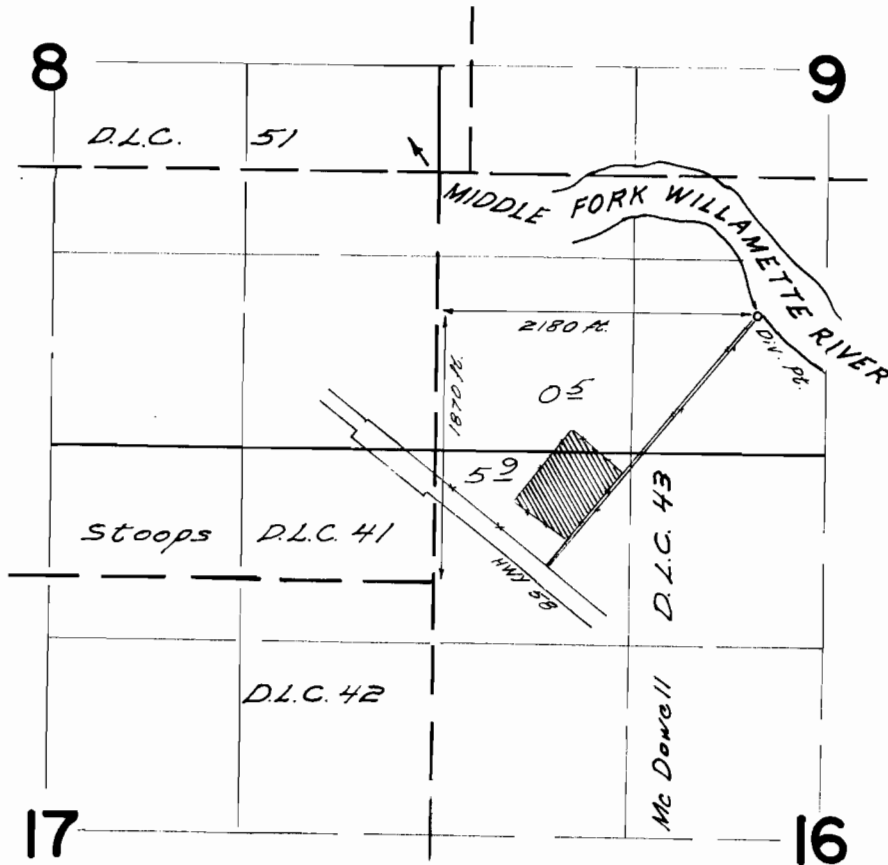

FINAL PROOF SURVEY UNDER

Application No. 37694 Permit No. 28088
IN NAME OF

Alma H. Butler

Surveyed *Sept 12 1967*, by *W.J. Ruppert*
Insp. Sept 23 1968 by *Ralph Jackson*