


T.21&22 S.R.IW.W.M.

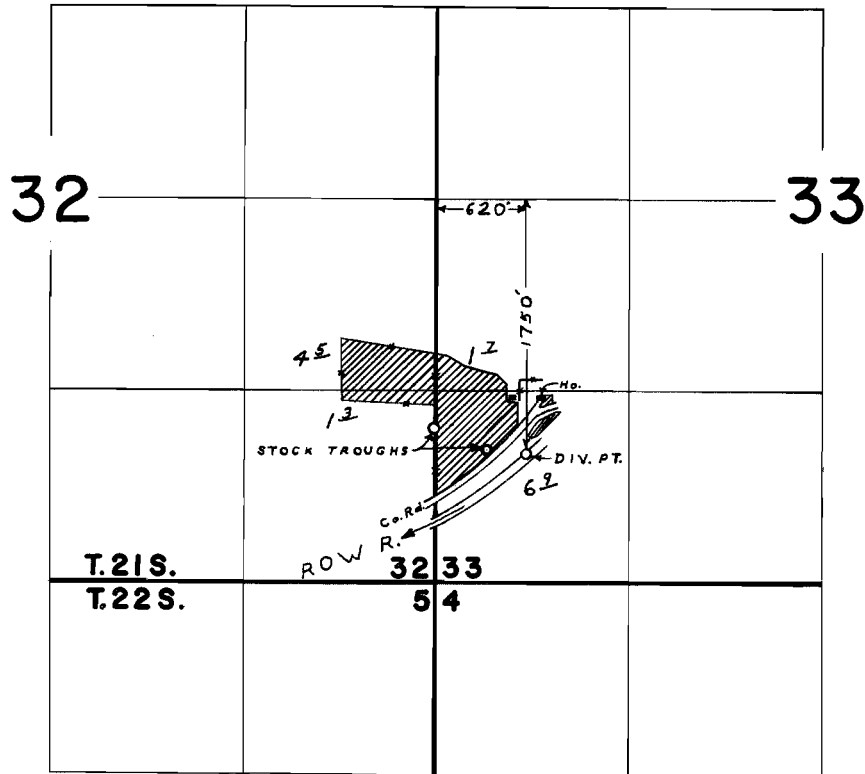

FINAL PROOF SURVEY UNDER

Application No. 40342 Permit No. 30082
IN NAME OF

WILLIAM & MARGARET EARNSHAW

Surveyed OCT. 10, 1968, by L. E. GOULD