


# T. 20S. R. 3W.W.M.

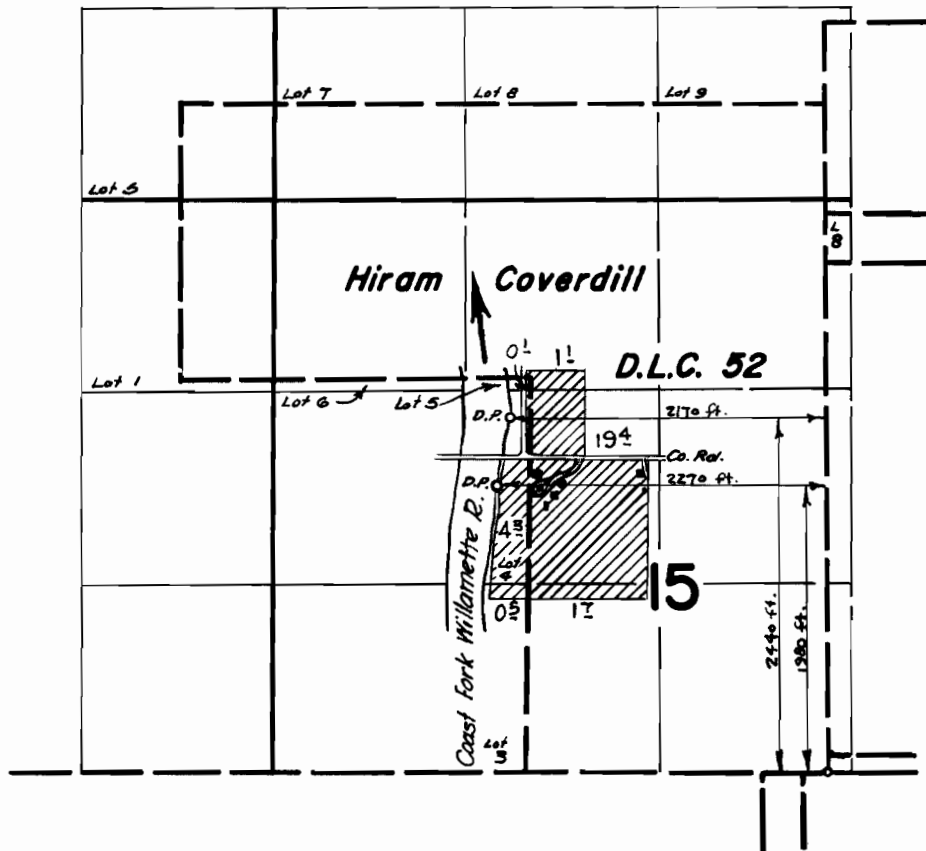

## FINAL PROOF SURVEY UNDER

Application No. 43048 Permit No. 32169  
IN NAME OF

**KENNETH C. & VELMA ZUMWALT**

Surveyed Sept. 10, 1968, by *R. Jackson*