


T.13S. RIW. W.M.

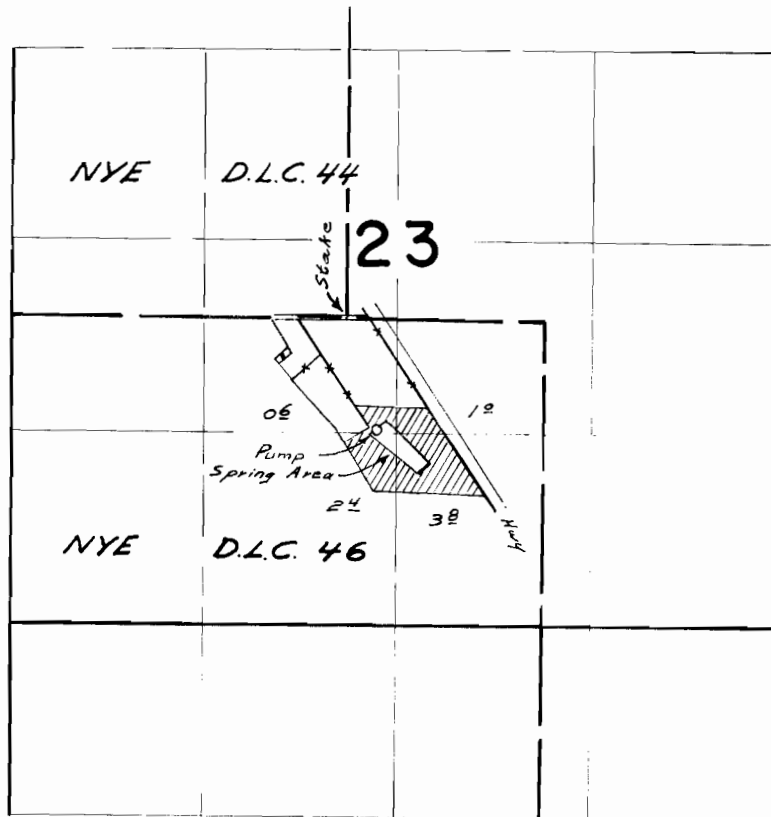

Div. Pl. located 880 ft. S. & 380 ft. E. from S.E. Cor. D.L.C. 44

FINAL PROOF SURVEY
UNDER

Application No. 34447 Permit No. 27045
IN NAME OF

THEODORE J. KELLUM

Surveyed March 27 1967, by W. J. Ruppert