


T. 4 S. R. 2 W. W.M.

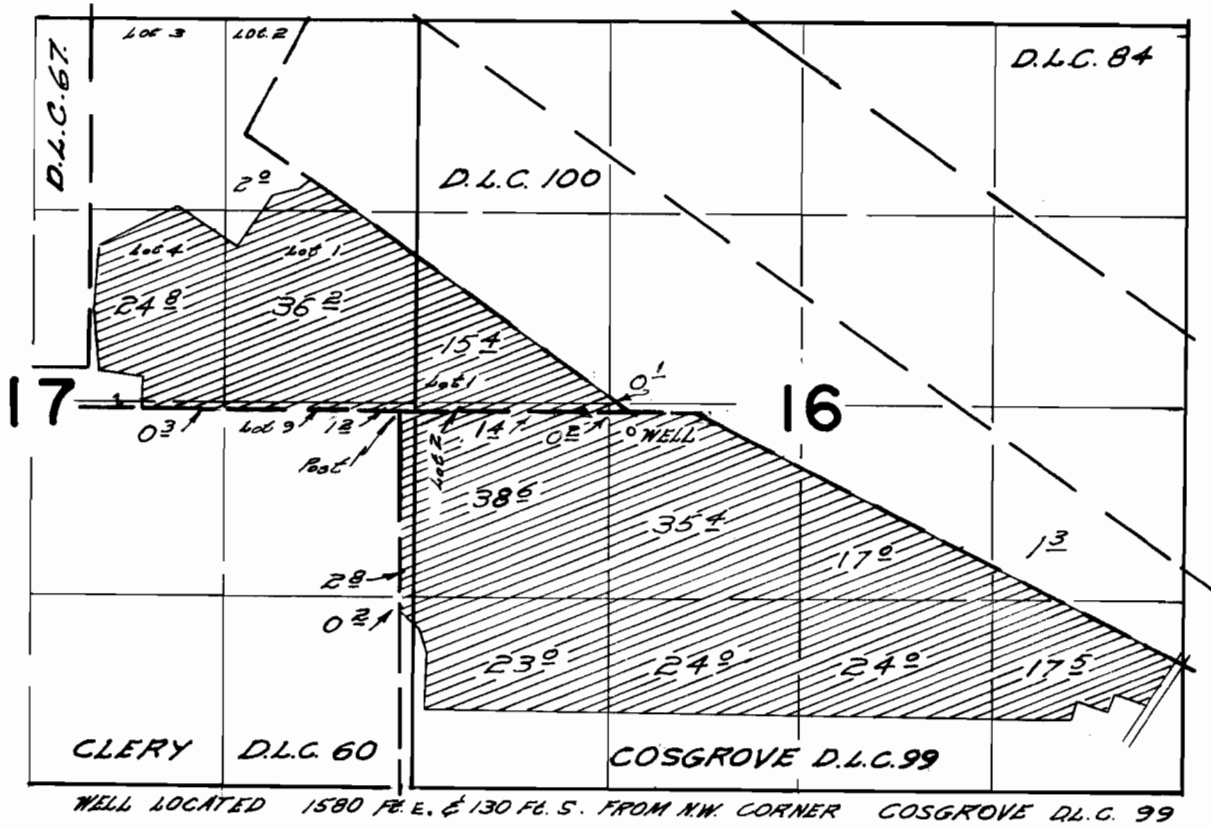

FINAL PROOF SURVEY UNDER

Application No. G-2666 Permit No. G-2544
IN NAME OF

JACK SMITH

Surveyed May 5th 1968, by W.J. Ruppert