


T. 6 S. R. 2 W. W.M.

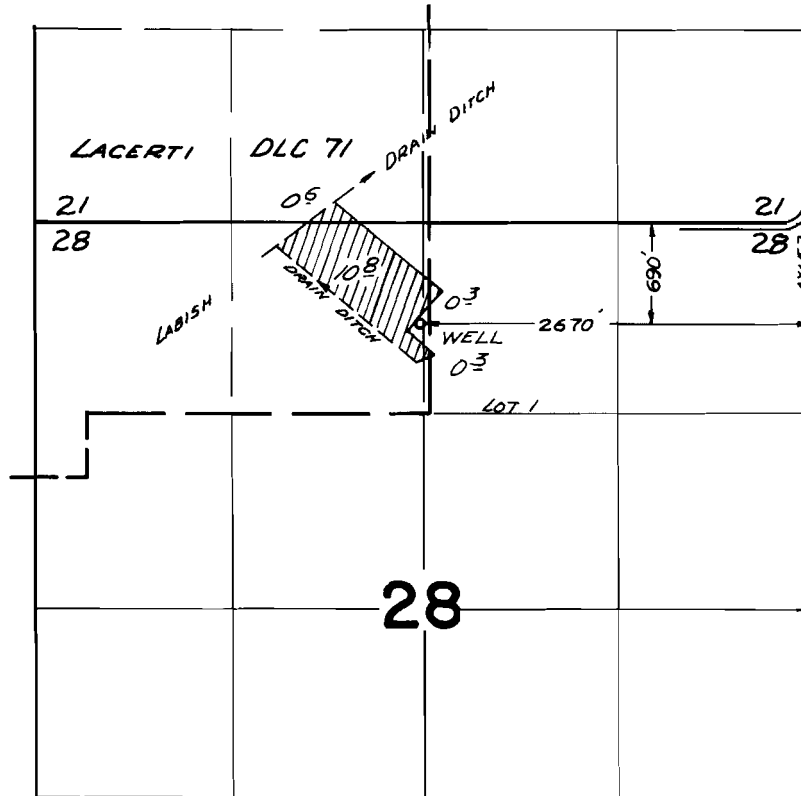

FINAL PROOF SURVEY UNDER

Application No. G:2976. Permit No. G:2764.
IN NAME OF

RONALD E. JONES

Surveyed APRIL 10, 1968, by V. GARNER