


T.5S. R.2 W. W.M.

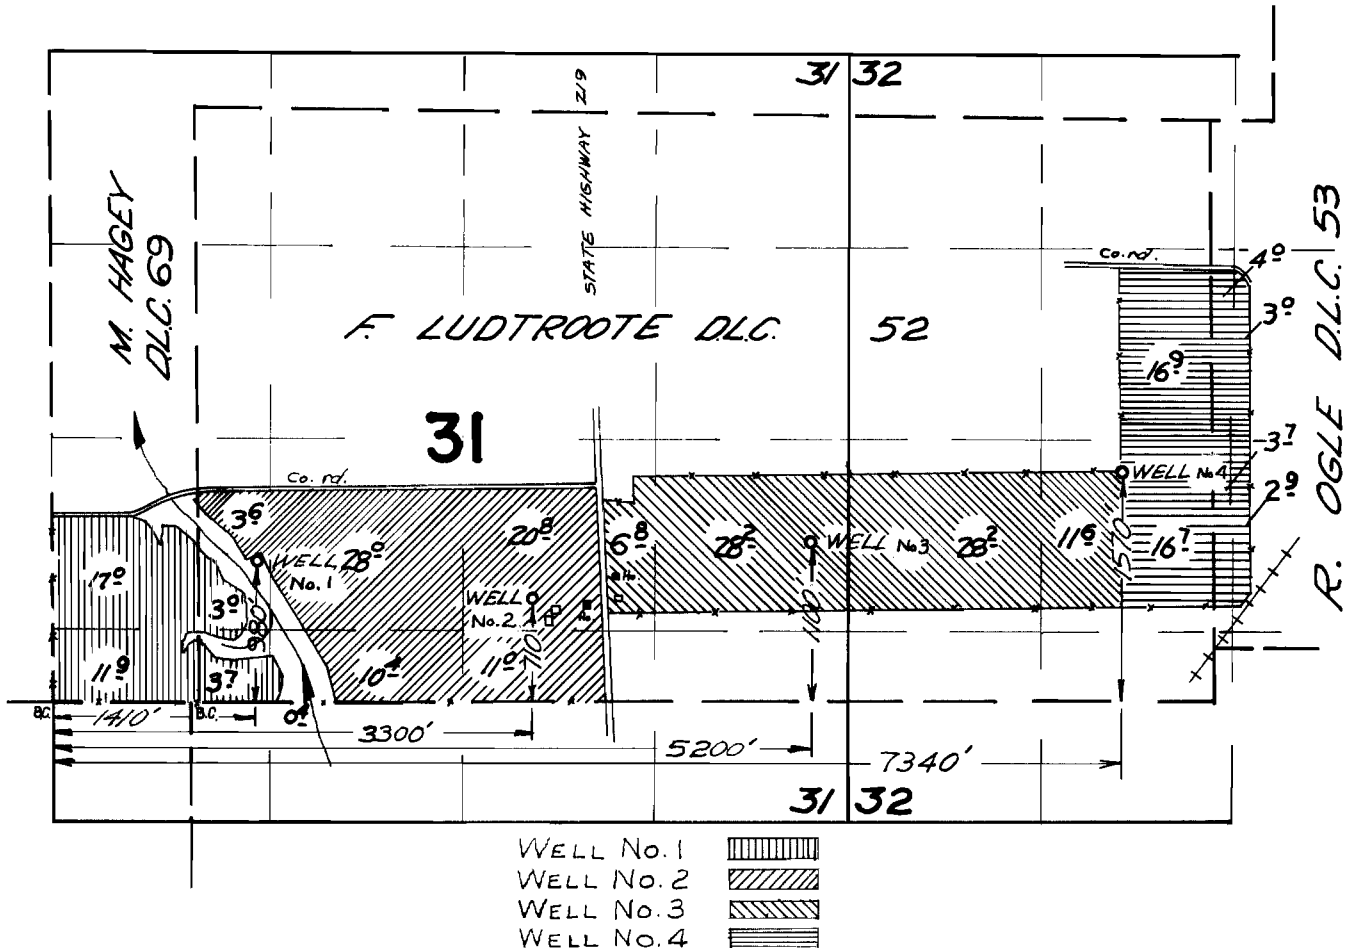

FINAL PROOF SURVEY UNDER

Application No. G-2918 Permit No. G-2954
IN NAME OF

ROBERT ZIELINSKI

Surveyed Sept. 29 1966 by V. GARNER