


T.9 & 10 S. R.2 W. W.M.

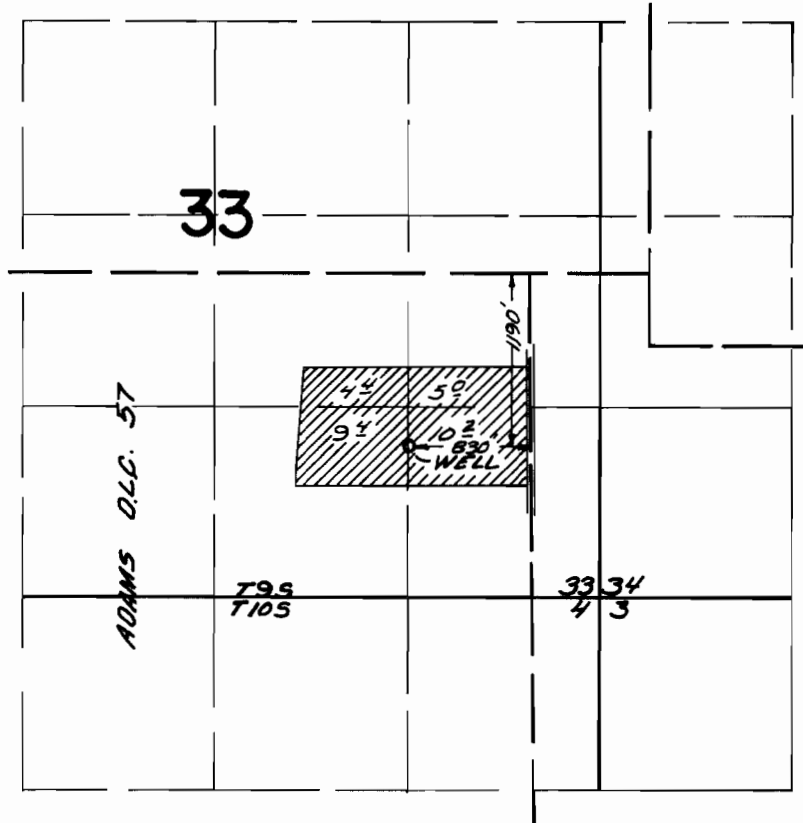

FINAL PROOF SURVEY
UNDER

Application No. ~~G. 3862~~ Permit No. ~~G. 3636~~
IN NAME OF

WILLIAM G. GRENZ

Surveyed July 25, 1968, by V. Garner