


T.6S. R.2W. W.M.

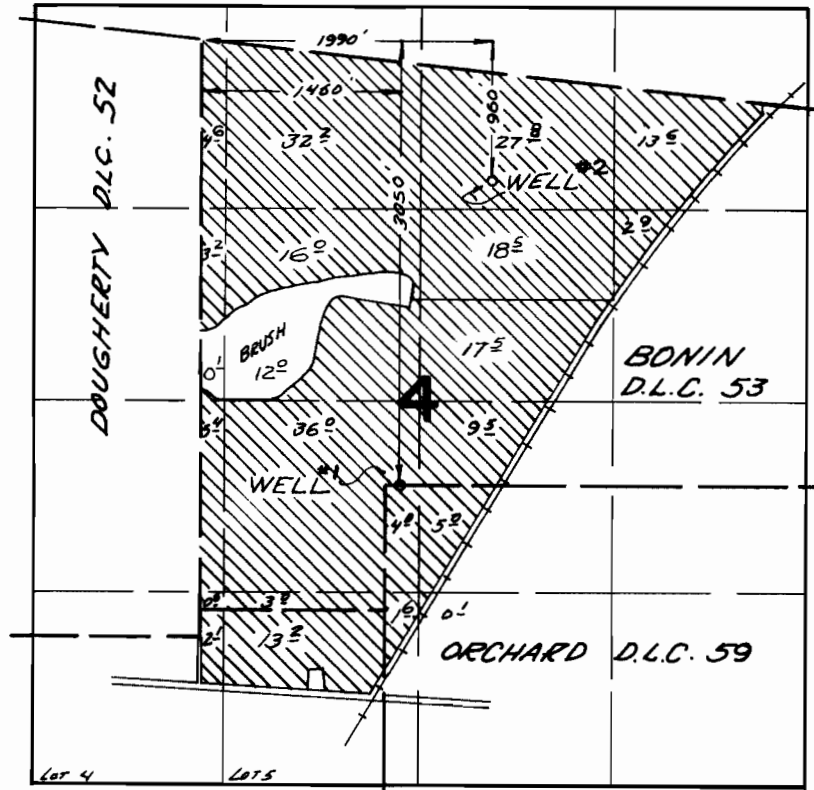

FINAL PROOF SURVEY UNDER

Application No. G-3933 Permit No. G-3689
IN NAME OF

FRED GOLDSMITH

Surveyed April 22 1968, by V. GARNER