


T. 6 S. R. 2 W. W.M.

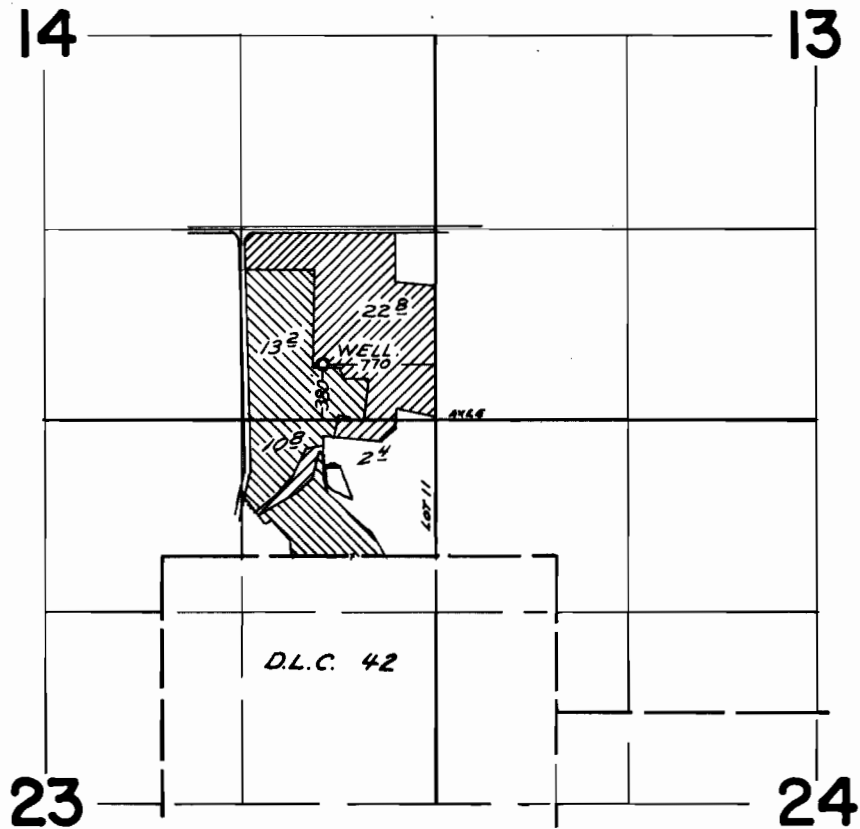

FINAL PROOF SURVEY
UNDER

Application No. *G-4028* Permit No. *G-3779*
IN NAME OF

GLENN GROAH

Surveyed *Aug. 14, 1968*, by *V. Garner*