


# T. 7 & 8 S. R. 1 E. W. M.

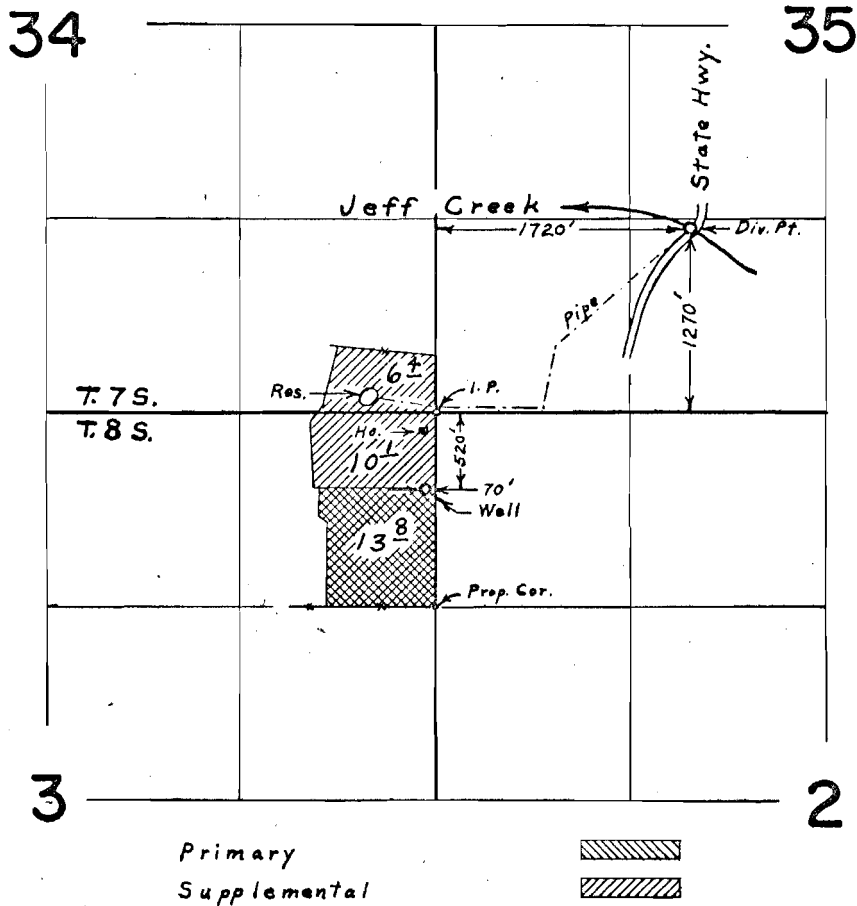

## FINAL PROOF SURVEY UNDER

G-4067                      G-3812  
 Application No. 43813    Permit No. 32756  
 IN NAME OF

RALPH A. & MARIAN B. JACK

Surveyed July 26, 1968, by L. E. Gould  
Aug. 15,