


T. 7 & 8 S. R. 1 W. & 1 E. W.M.

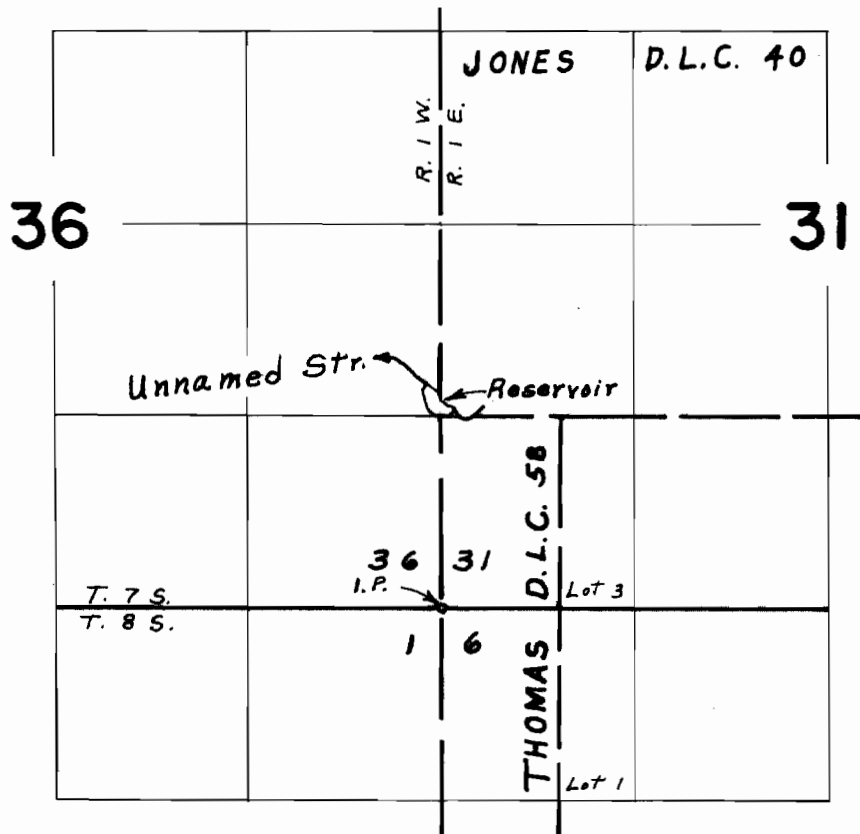

FINAL PROOF SURVEY UNDER

Application No. R-43890 Permit No. R-4975
IN NAME OF

LOUIS & ALICE J. SCHACHT

Surveyed July 3, 1968, by L. E. Gould