


T.7&8S. R.3&4W. W.M.

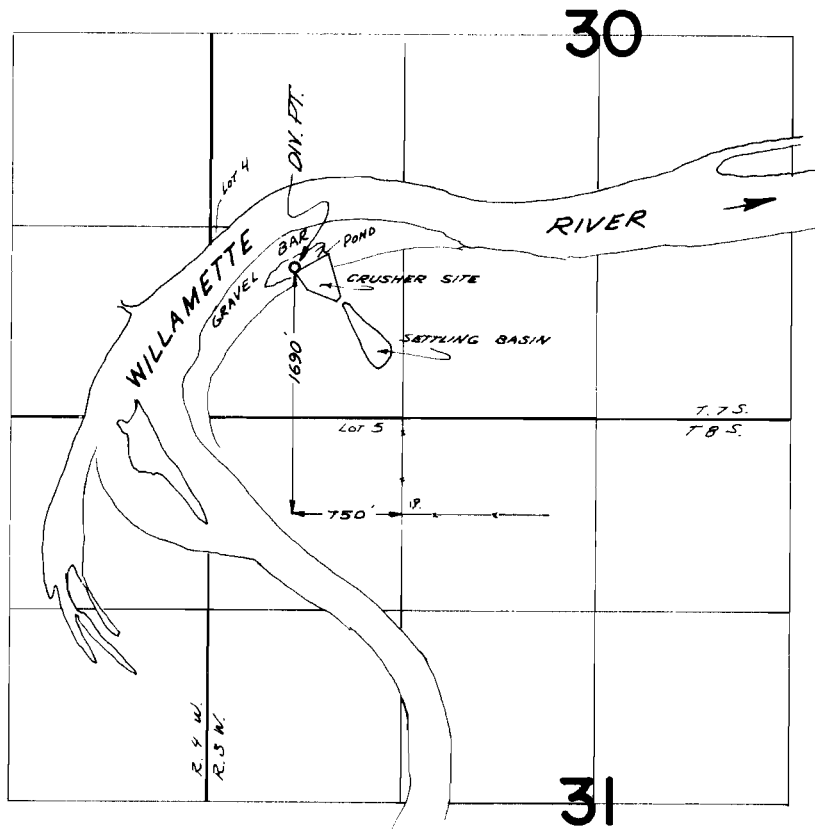

FINAL PROOF SURVEY
UNDER

Application No. 38842 Permit No. 28996
IN NAME OF

COMMERCIAL SAND and GRAVEL SUPPLY COMPANY

Surveyed Aug. 15, 1968, by *V. Garner*.