


0024
11/24 from file S-41746

T. 8S. R. 1E. W. M.

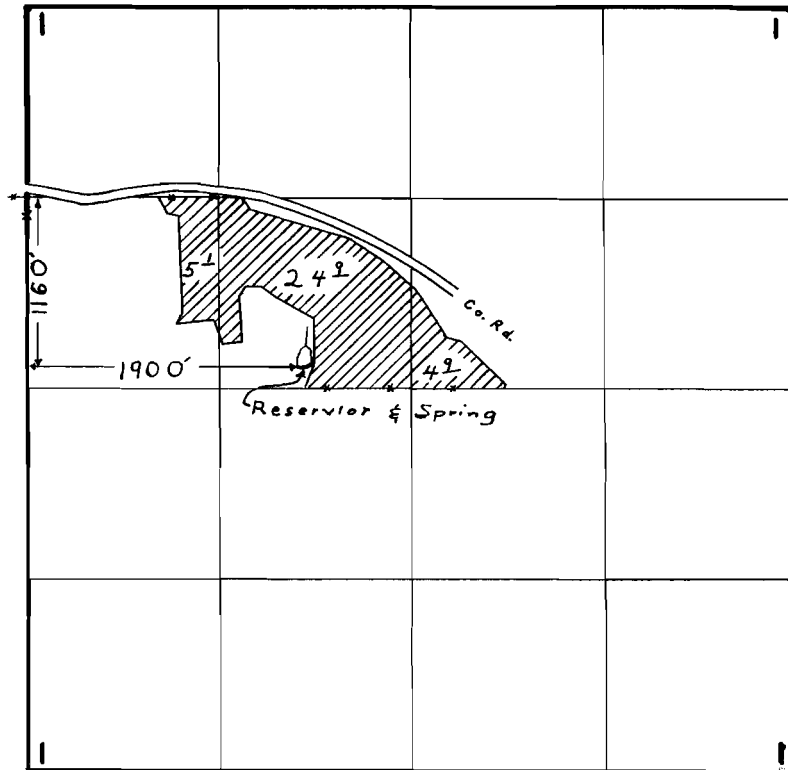

FINAL PROOF SURVEY
UNDER

R-41746 R-4707
Application No. **41747** Permit No. **31165**
IN NAME OF

ROBERT F. DESANTIS

Surveyed **AUG. 14, 1968**, by **L. E. GOULD**