


T.8S.R.1&2E.W.M.

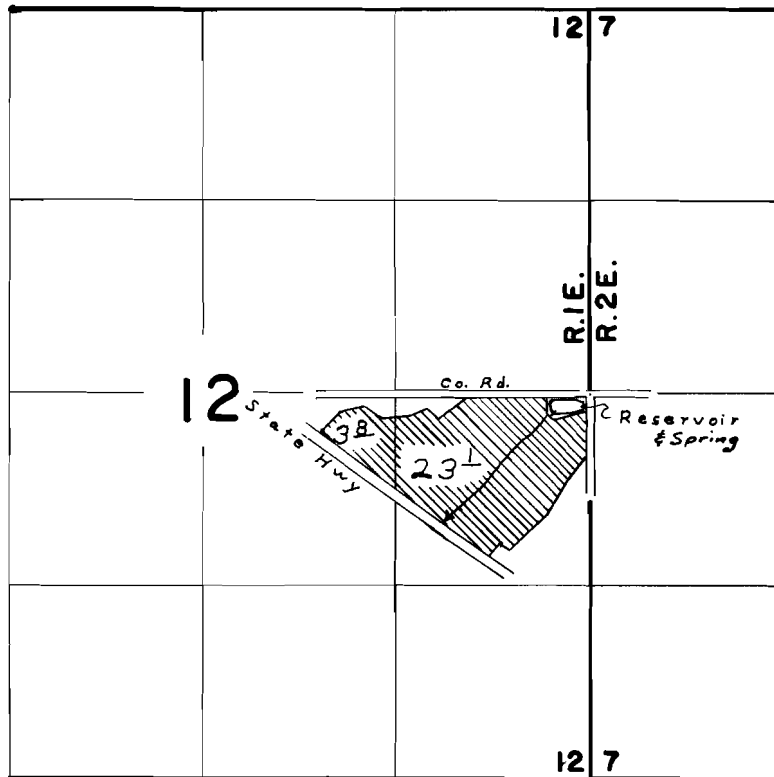

Div. Pt. located 120' S & 260' W from E $\frac{1}{4}$ cor. Sec. 12

FINAL PROOF SURVEY UNDER

R-41748 R-4708
Application No. 41749 Permit No. 31166
IN NAME OF

ROBERT F. DESANTIS

Surveyed AUG. 15 1968, by L. E. GOULD