


T. 9 S. R. 3 E. W. M.

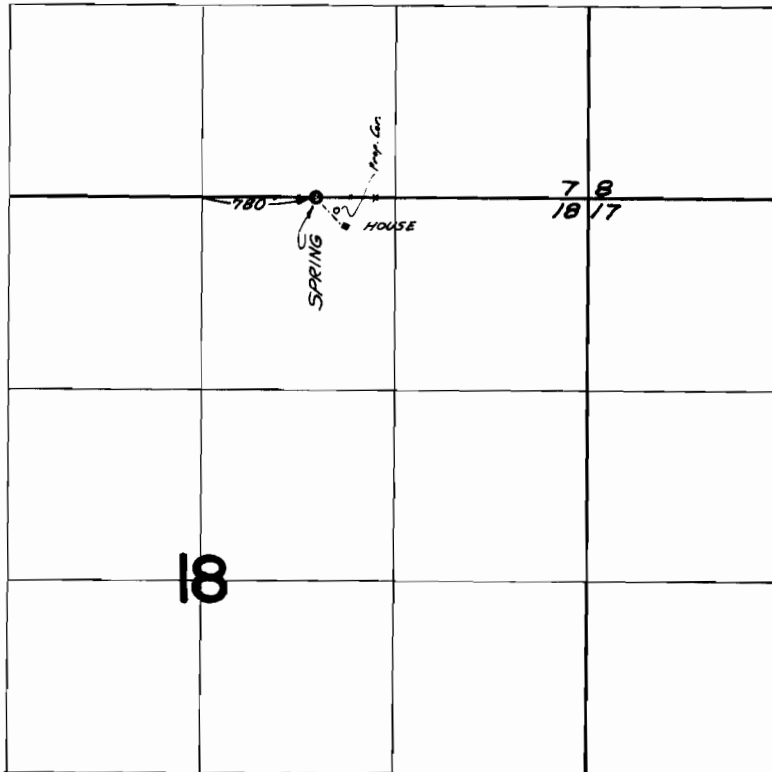

FINAL PROOF SURVEY
UNDER

Application No. 39826 Permit No. 29594
IN NAME OF

C. RALPH VORIS JR.

Surveyed *Sept 5*, 1968, by *V. Garner*