


T. 5 & 6 S. R. 1 W. W. M.

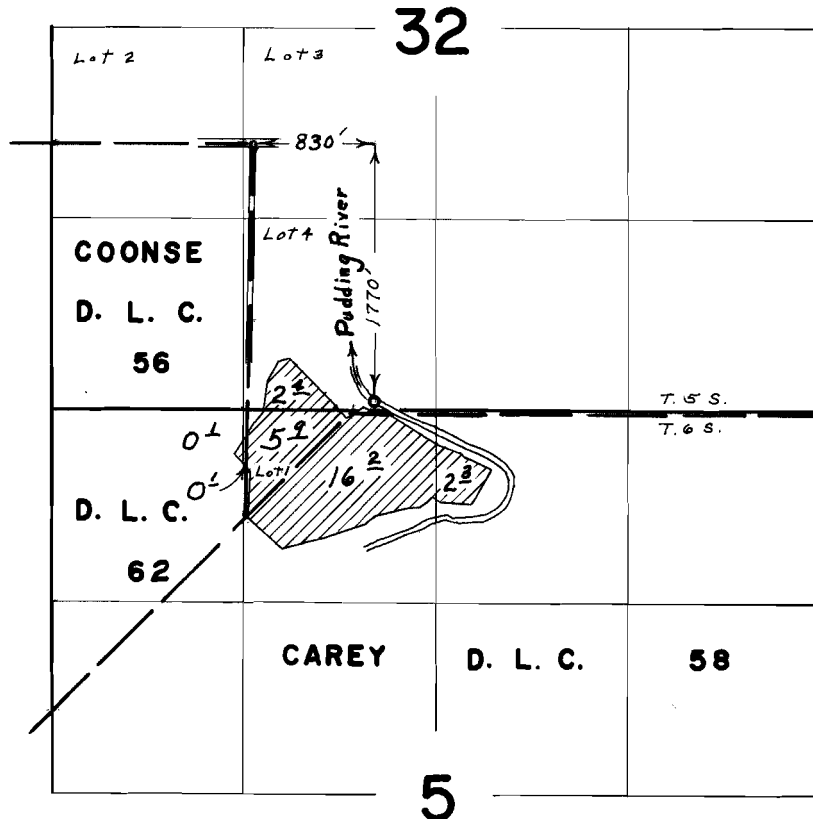

FINAL PROOF SURVEY UNDER

Application No. 40172 Permit No. 29944
IN NAME OF

THOMAS P. & EVANELLE E. EWING

Surveyed May 7, 1968, by L. E. Gould