


# T. 7 S. R. 2 W. W.M.

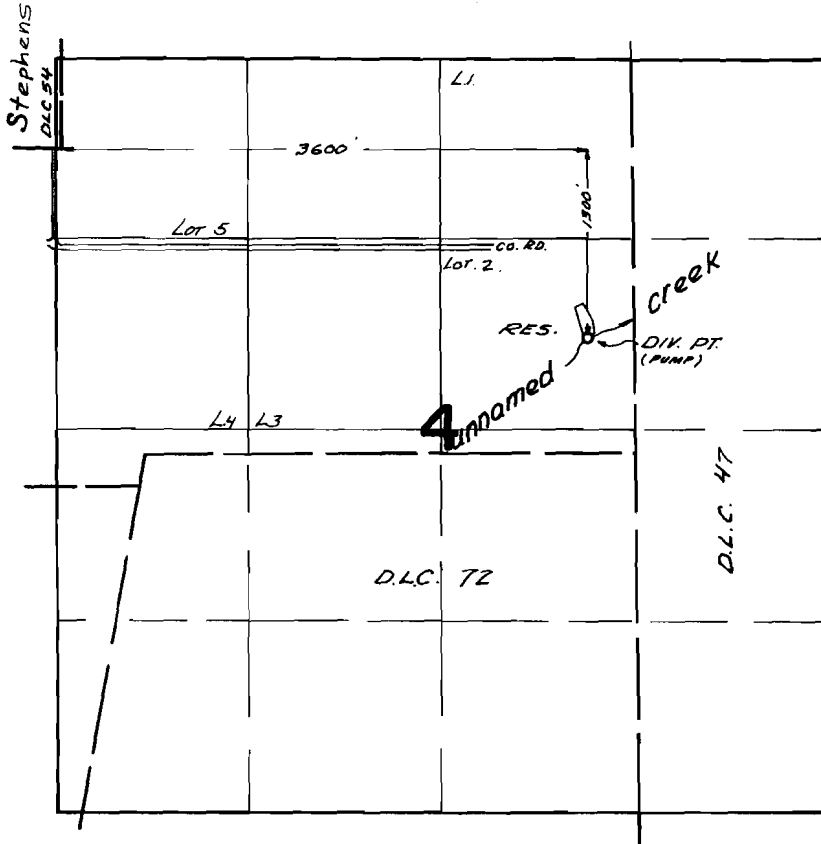

## FINAL PROOF SURVEY UNDER

R-40803                      R-4570  
Application No. 40804 Permit No. 30400  
IN NAME OF

EDWARD CURTIS

Surveyed June 19, 1968, by V. G. Garner