


T. 7 S. R. 2 W. W.M.

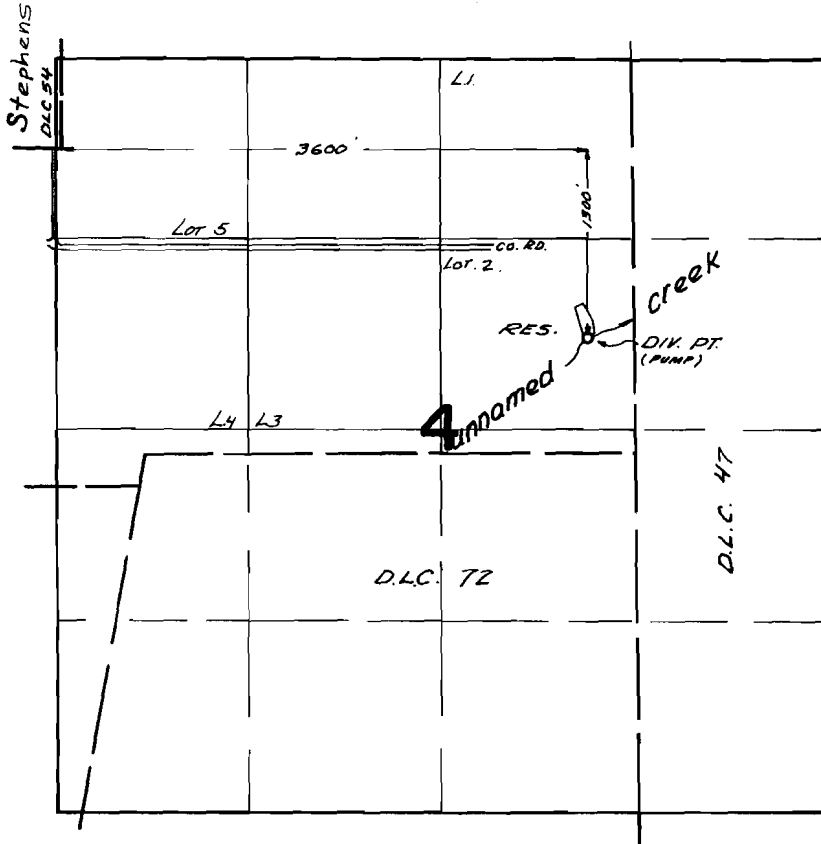

FINAL PROOF SURVEY UNDER

R-40803 R-4570
Application No. 40804 Permit No. 30400
IN NAME OF

EDWARD CURTIS

Surveyed June 19, 1968, by V. G. Garner