


T. 10S. R. 6E. W.M.

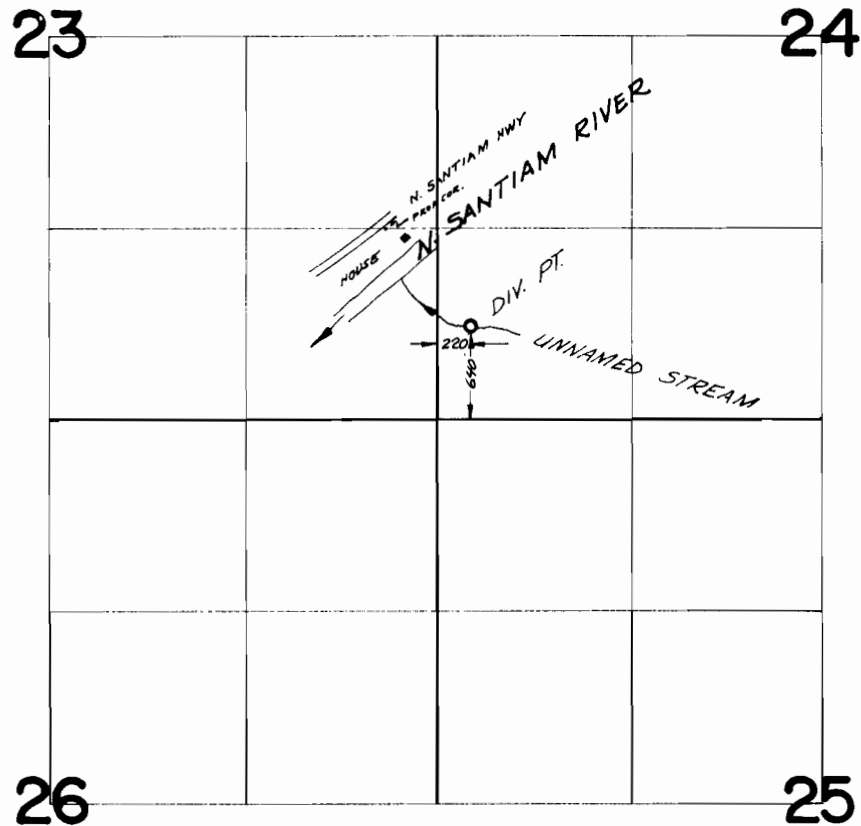

FINAL PROOF SURVEY
UNDER

Application No. 41131 Permit No. 30664
IN NAME OF

GLEN and ANNA L. BLAIR

Surveyed *Sept. 5, 1968*, by *V. Garner*