


T. 6 S. R. 1 W. W. M.

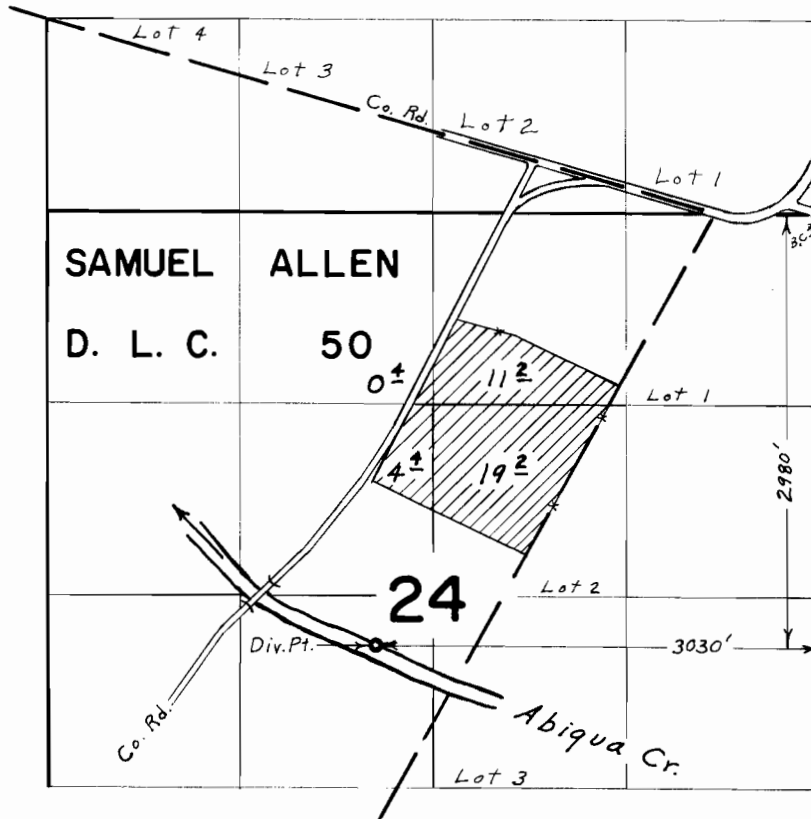

FINAL PROOF SURVEY UNDER

Application No. 41813 Permit No. 31300
IN NAME OF

AMMON BROTHERS, INC.

Surveyed April 22, 1968, by L. E. Gould