


T.7S.R.1E.W.M.

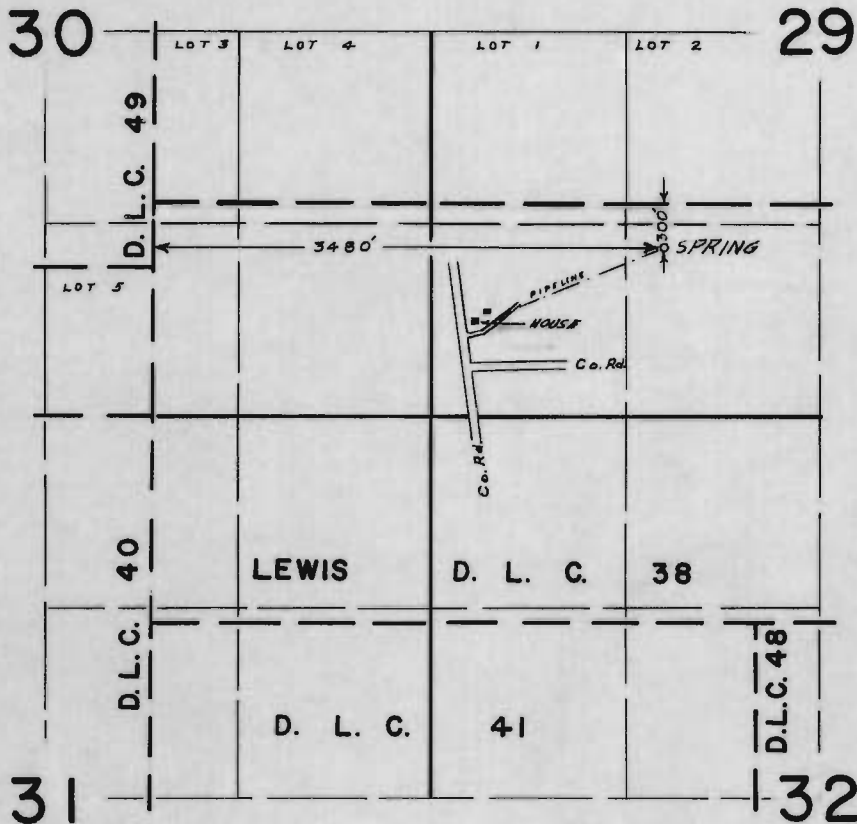

FINAL PROOF SURVEY

Application No. **42145** Permit No. **31517**
IN NAME OF

F DWAIN & MABLE MAE HICKMAN

Surveyed **SEPT. 4, 1968**, by **L. E. GOULD**