


T.8S.R.1E. W.M.

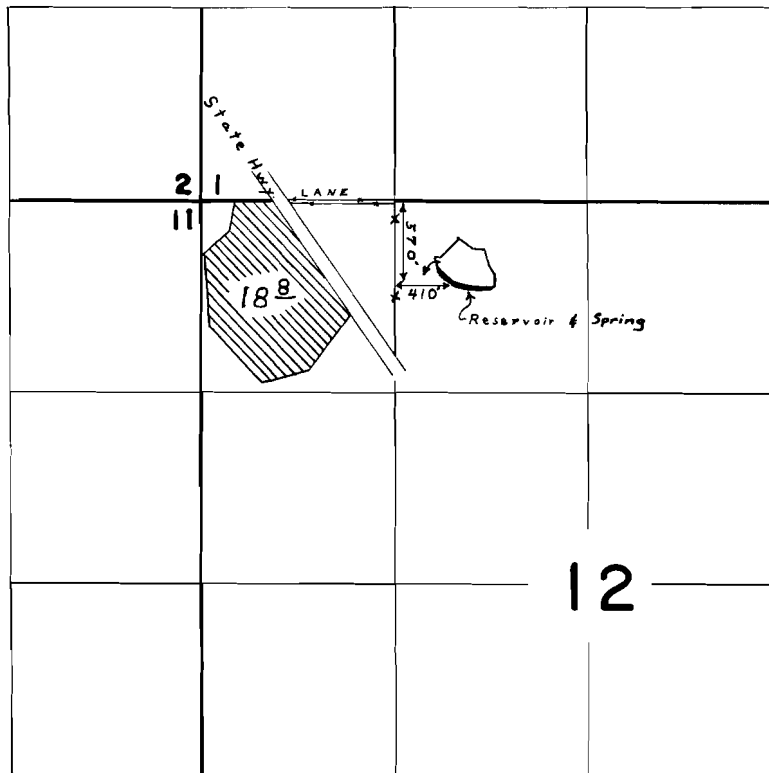

FINAL PROOF SURVEY
UNDER

R-42219 R-4863
Application No. 42220 Permit No. 31957
IN NAME OF

BEN BLEAKNEY

Surveyed AUG.14 1968, by L. E. GOULD