


# T. 8 S. R. 4 E. W. M.

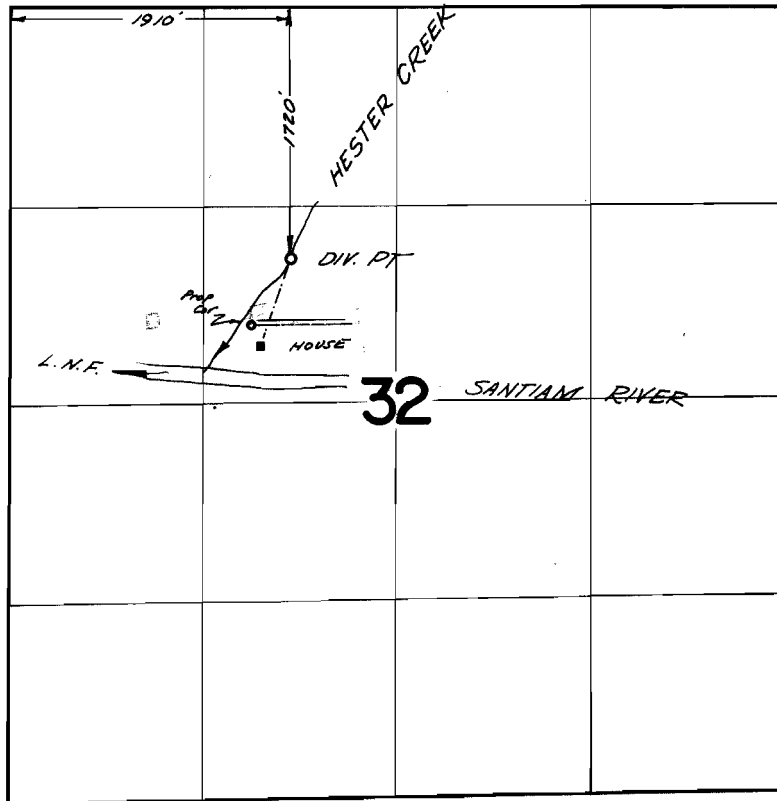

## FINAL PROOF SURVEY UNDER

Application No. 43477 Permit No. 32519  
IN NAME OF

GEORGE B. and LENABEL MITCHELL

Surveyed Sept. 5 1968 by V. Garner