


T.7S.R.IW.W.M.

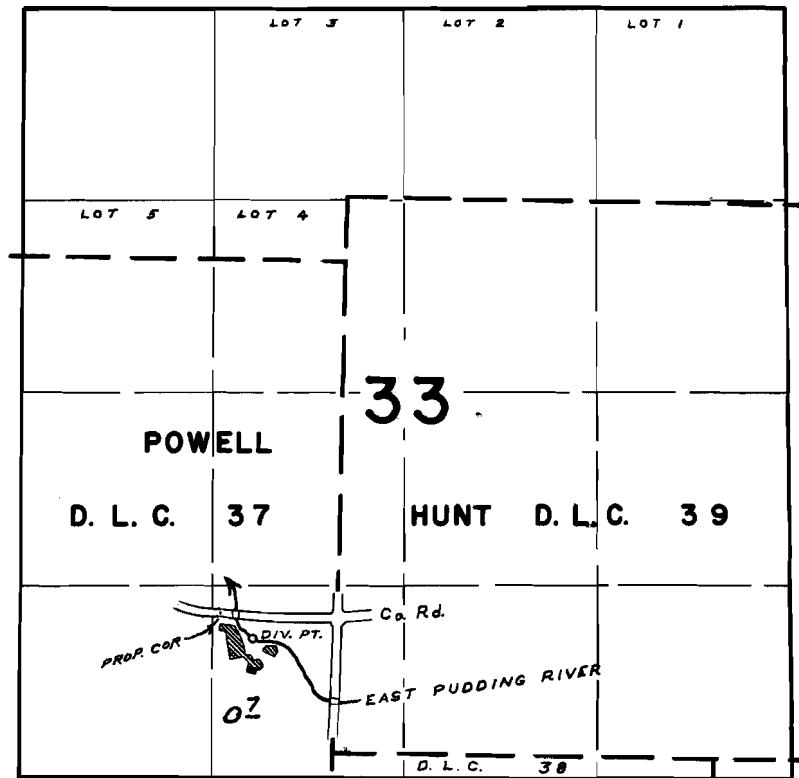

DIV. PT. LOCATED 780' N & 540' W FROM SW COR. HUNT D.L.C. 39

FINAL PROOF SURVEY
UNDER

Application No. **43579** Permit No. **32588**
IN NAME OF

ANDREW H. MESSMAN

Surveyed **SEPT. 5 1968**, by **L. E. GOULD**