


T. 9 S. R. 3 E. W. M.

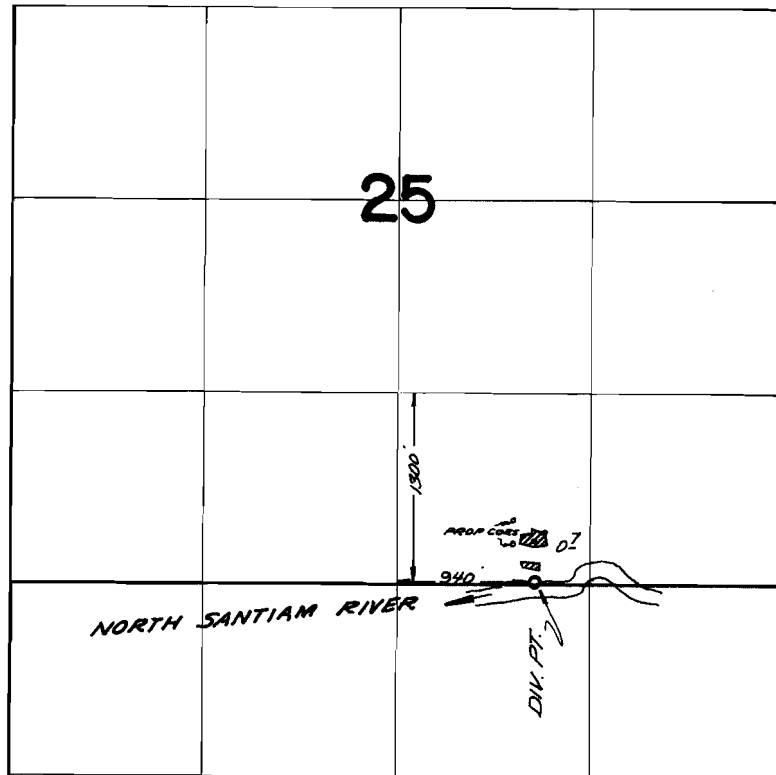

FINAL PROOF SURVEY UNDER

Application No. 43952 Permit No. 32837
IN NAME OF

.....*COLLETT A. RUST*.....

Surveyed *Sept. 6 1968*, by *V. Garner*.....