


T. 8 S. R. 6 W. W.M.

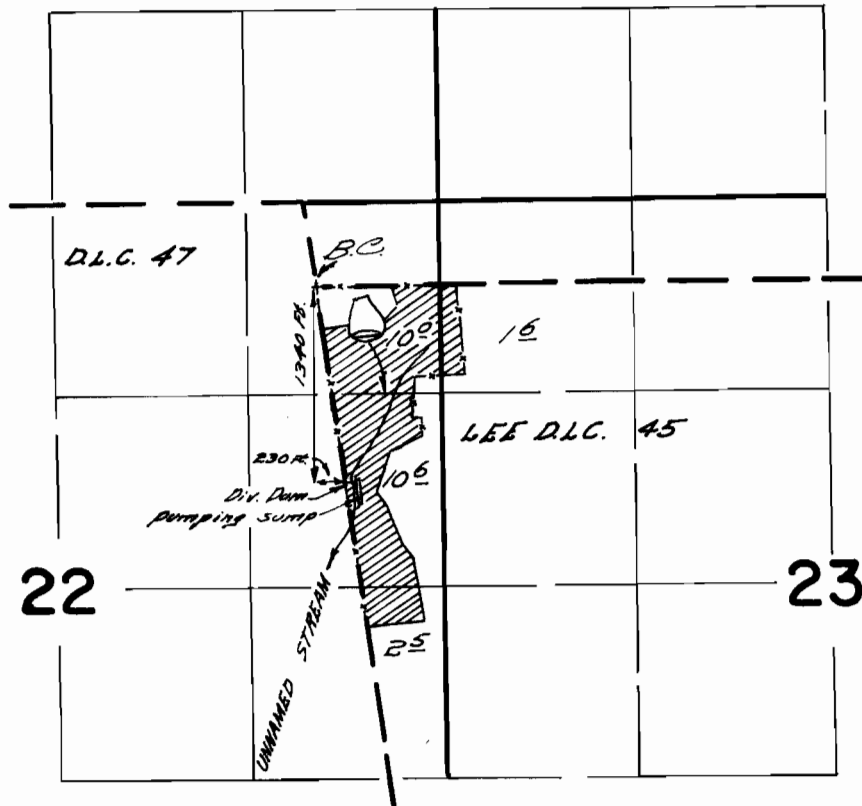

FINAL PROOF SURVEY UNDER

Application No. *37624* Permit No. *28057*
IN NAME OF

ELDON R. FRINK

Surveyed *Sept 5* 1968, by *W. J. Reppert*