


T.6S. R.7W. W.M.

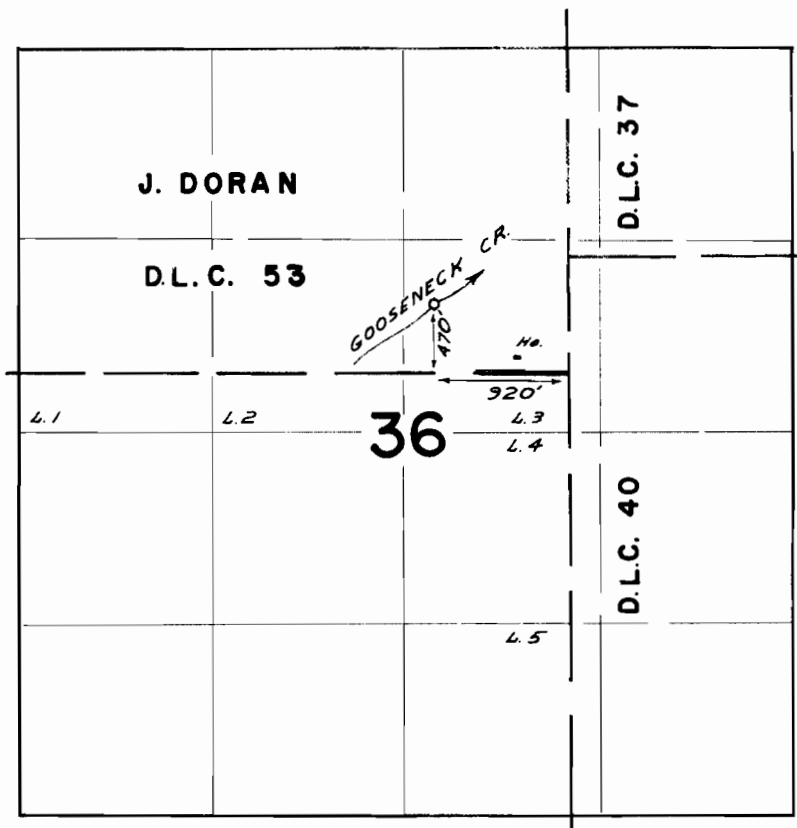

FINAL PROOF SURVEY  
UNDER

Application No. 41153 ... Permit No. 30680.  
IN NAME OF

*GLEN A. & DOROTHY BAKER*

Surveyed APR. 29 1966., by *W. J. Haggart*