


T.2S. R.10W. W.M.

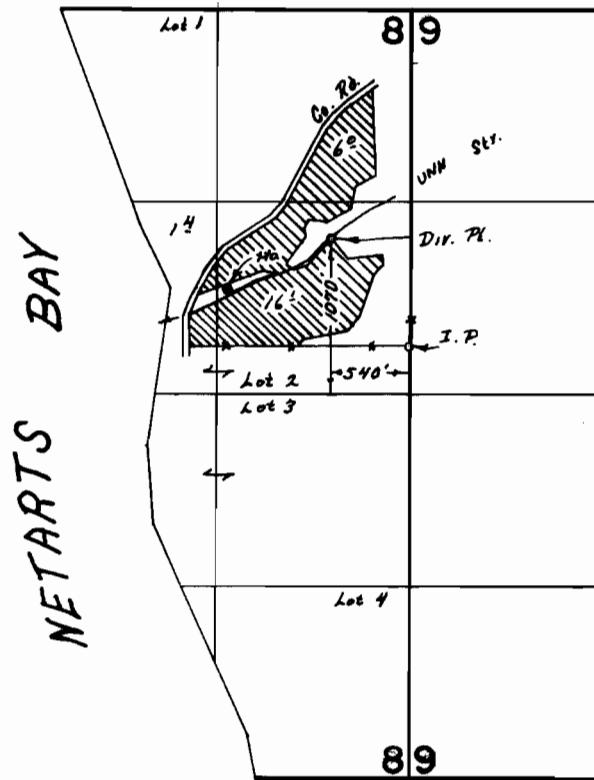

FINAL PROOF SURVEY
UNDER

Application No. 37614 Permit No. 28058
IN NAME OF

ROY A. & NOMA I. FISHER

Surveyed Oct. 4 1968, by L. E. Gould