T.4S.R.10W.W.M.

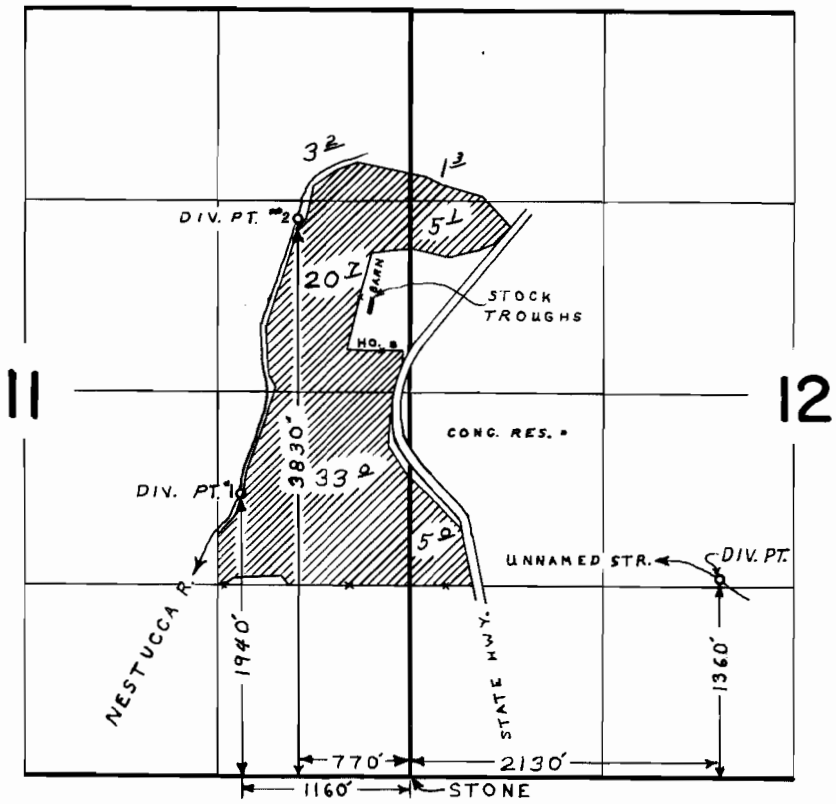

FINAL PROOF SURVEY
UNDER

Application No. **38667** Permit No. **28775**
IN NAME OF

TONY HURLIMAN

Surveyed **OCT. 3** 19**68**, by **L. E. GOULD**

1968-4