


T. 5 S. R. 10 W. W. M.

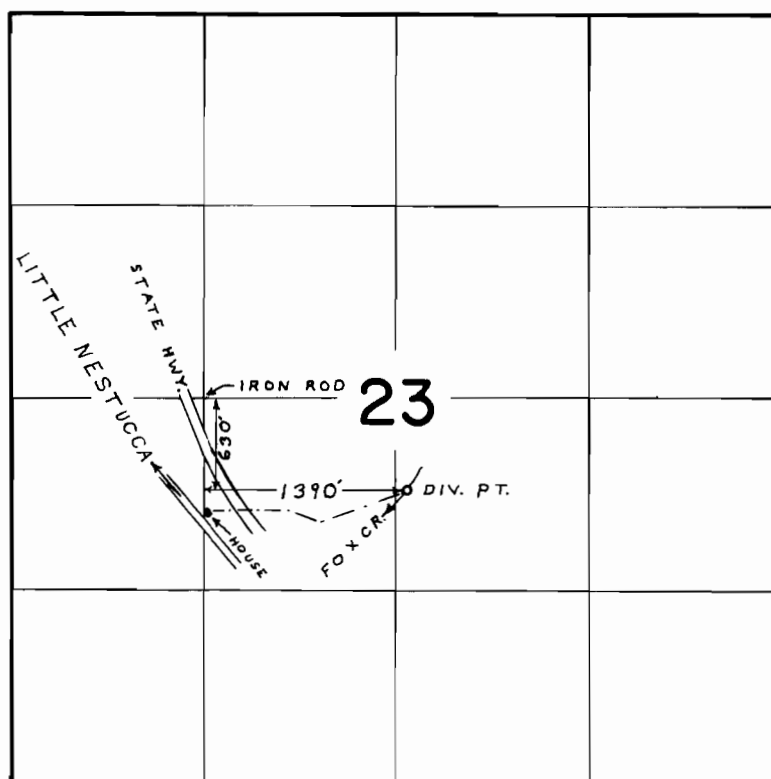

FINAL PROOF SURVEY
UNDER

Application No. **41463** Permit No. **30957**
IN NAME OF

ALBERT H. FOX and/or
ROSALIND M. FOX

Surveyed **OCT. 2 1968**, by **L. E. GOULD**